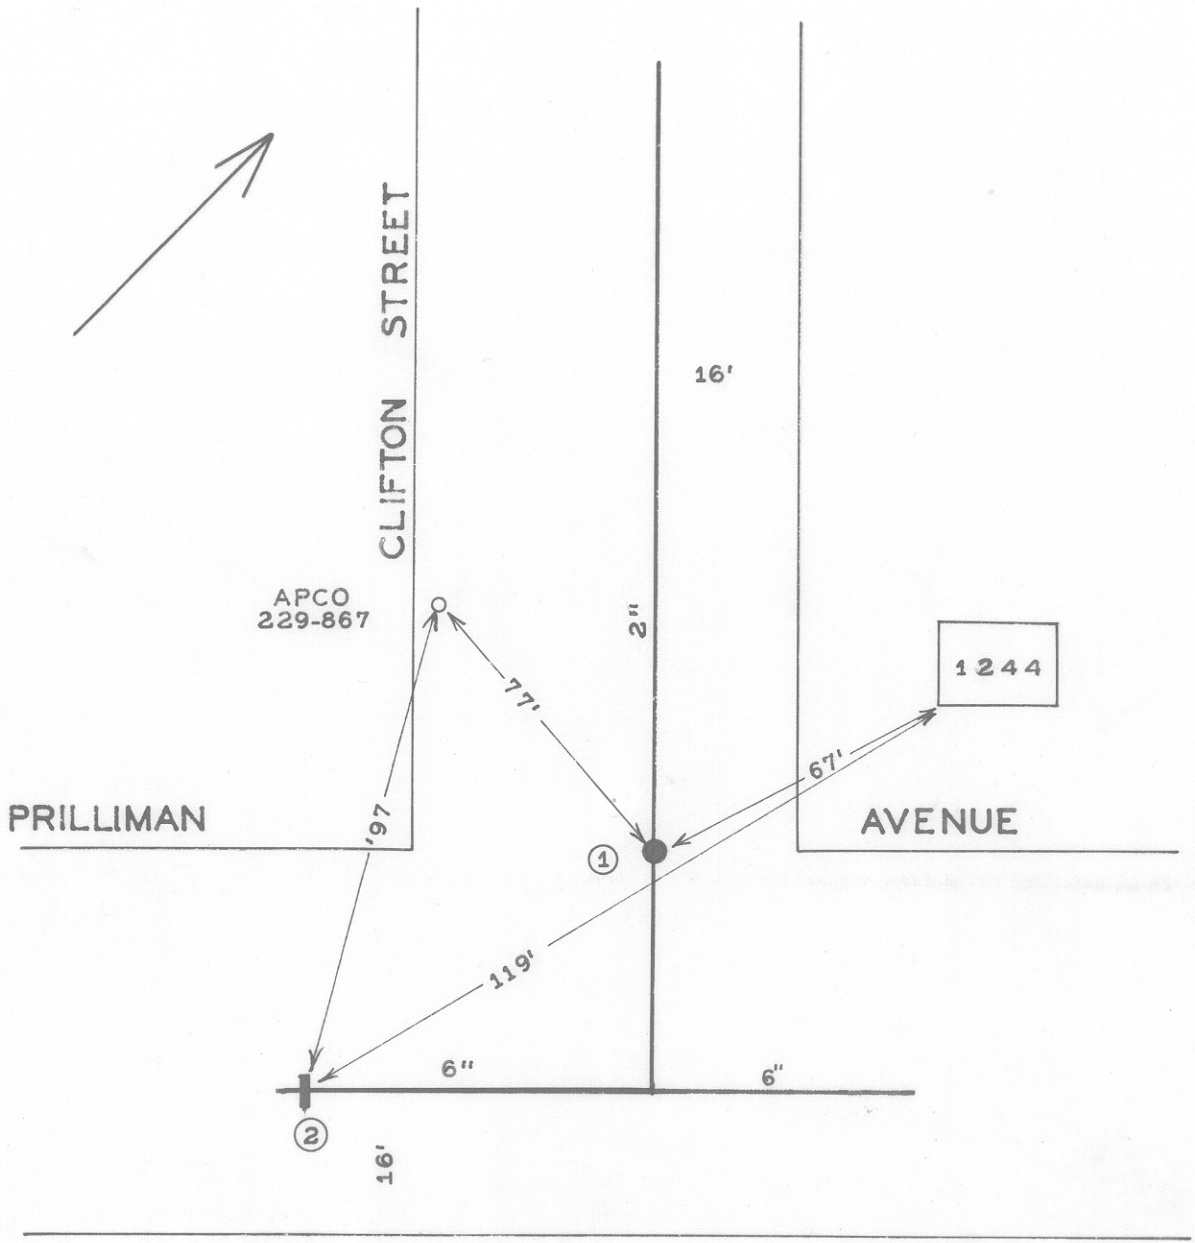

DATE	NO.	SIZE	MAKE	OPEN	TURNS
'59	1	2"	DARLING	R	
'59	2	2"	MISC.	L	
	1	0	N.W.P.L.		
	2	7'S	S.P.L.		

CITY OF ROANOKE — WATER DEPT.

VALVE DIAGRAM

CLIFTON STREET &

PRILLIMAN AVENUE N.W.

SEC. MAP 244

DATE PAGE NO.

5/88 NP

"IMPERIAL" TRACING CLOTH
K & E CO., N.Y.