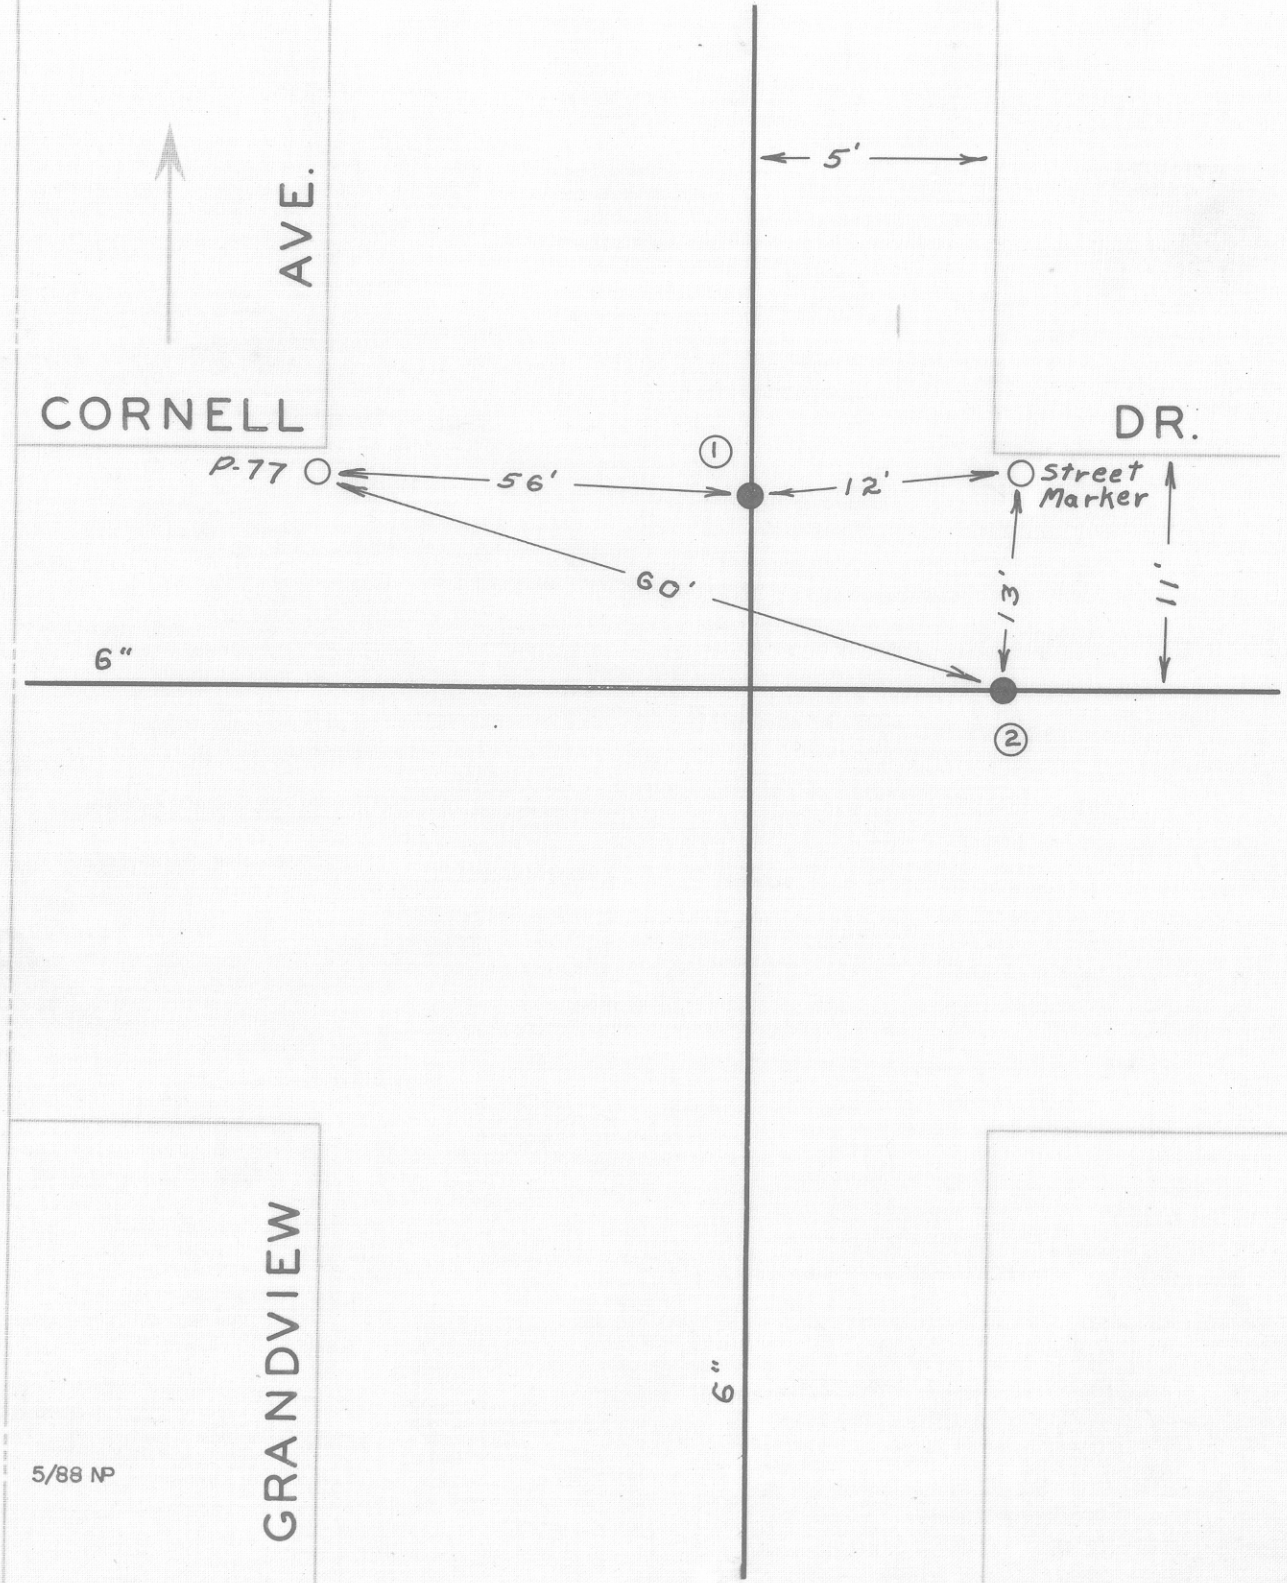

DATE	NO.	SIZE	MAKE	OPEN	TURNS
1951	1	6"			
1951	2	6"			
	1	8'-S	NPL		
	2	0	EPL		

5/88 NP

CITY OF ROANOKE—WATER DEP'T

VALVE DIAGRAM

CORNELL DR. & GRAND-VIEW AVE. N. W.

SEC. MAP 226

DATE W. R. PAGE NO.