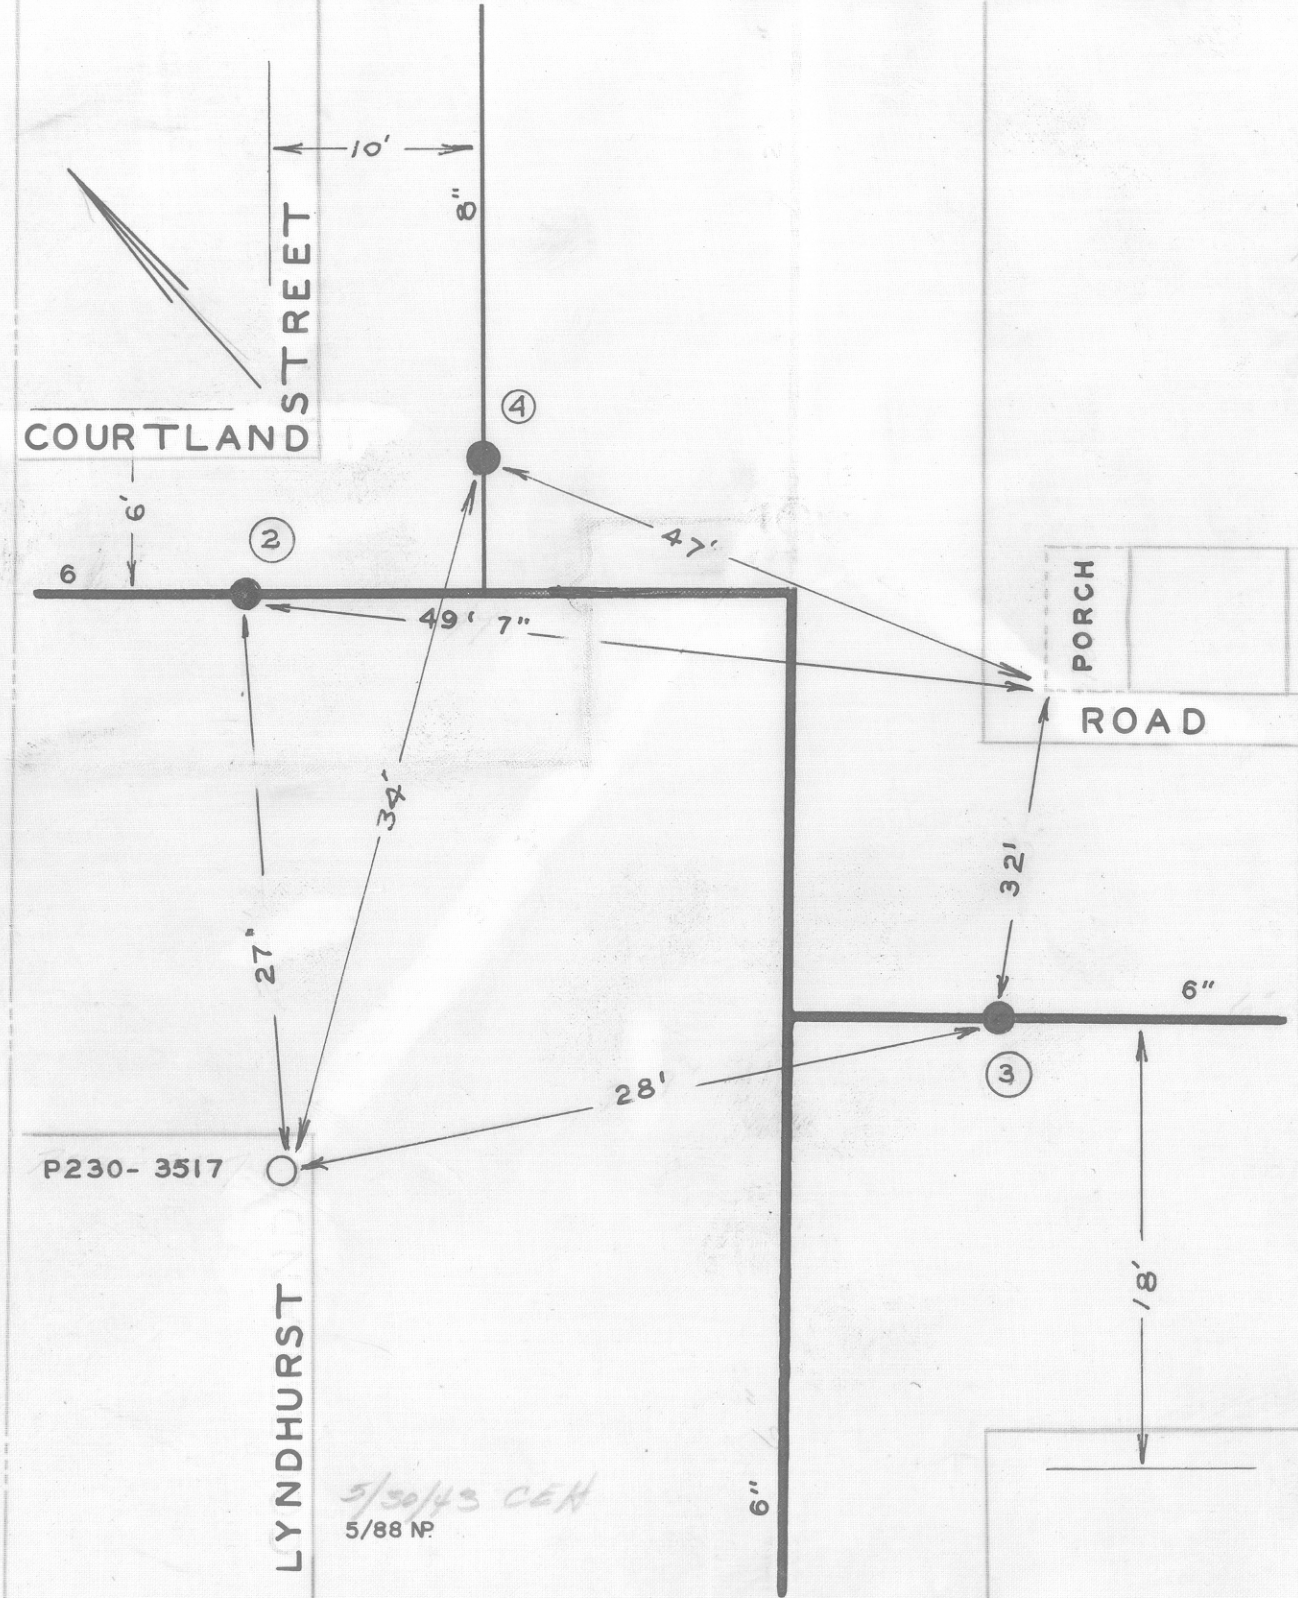

DATE	NO.	SIZE	MAKE	OPEN	TURNS
1925	1	ABANDONDED			
1942	2	6"		R	21
1942	3	6"		R	21
1954	4	8"		R	CH
	2	3'-E	WPL		
	3	2'-W	EPL		
	4	0	NPL		

CITY OF ROANOKE—WATER DEP'T

VALVE DIAGRAM

COURTLAND RD. &

LYNDHURST STREET N.W.

SEC. MAP 206

DATE

PAGE NO. NW 73