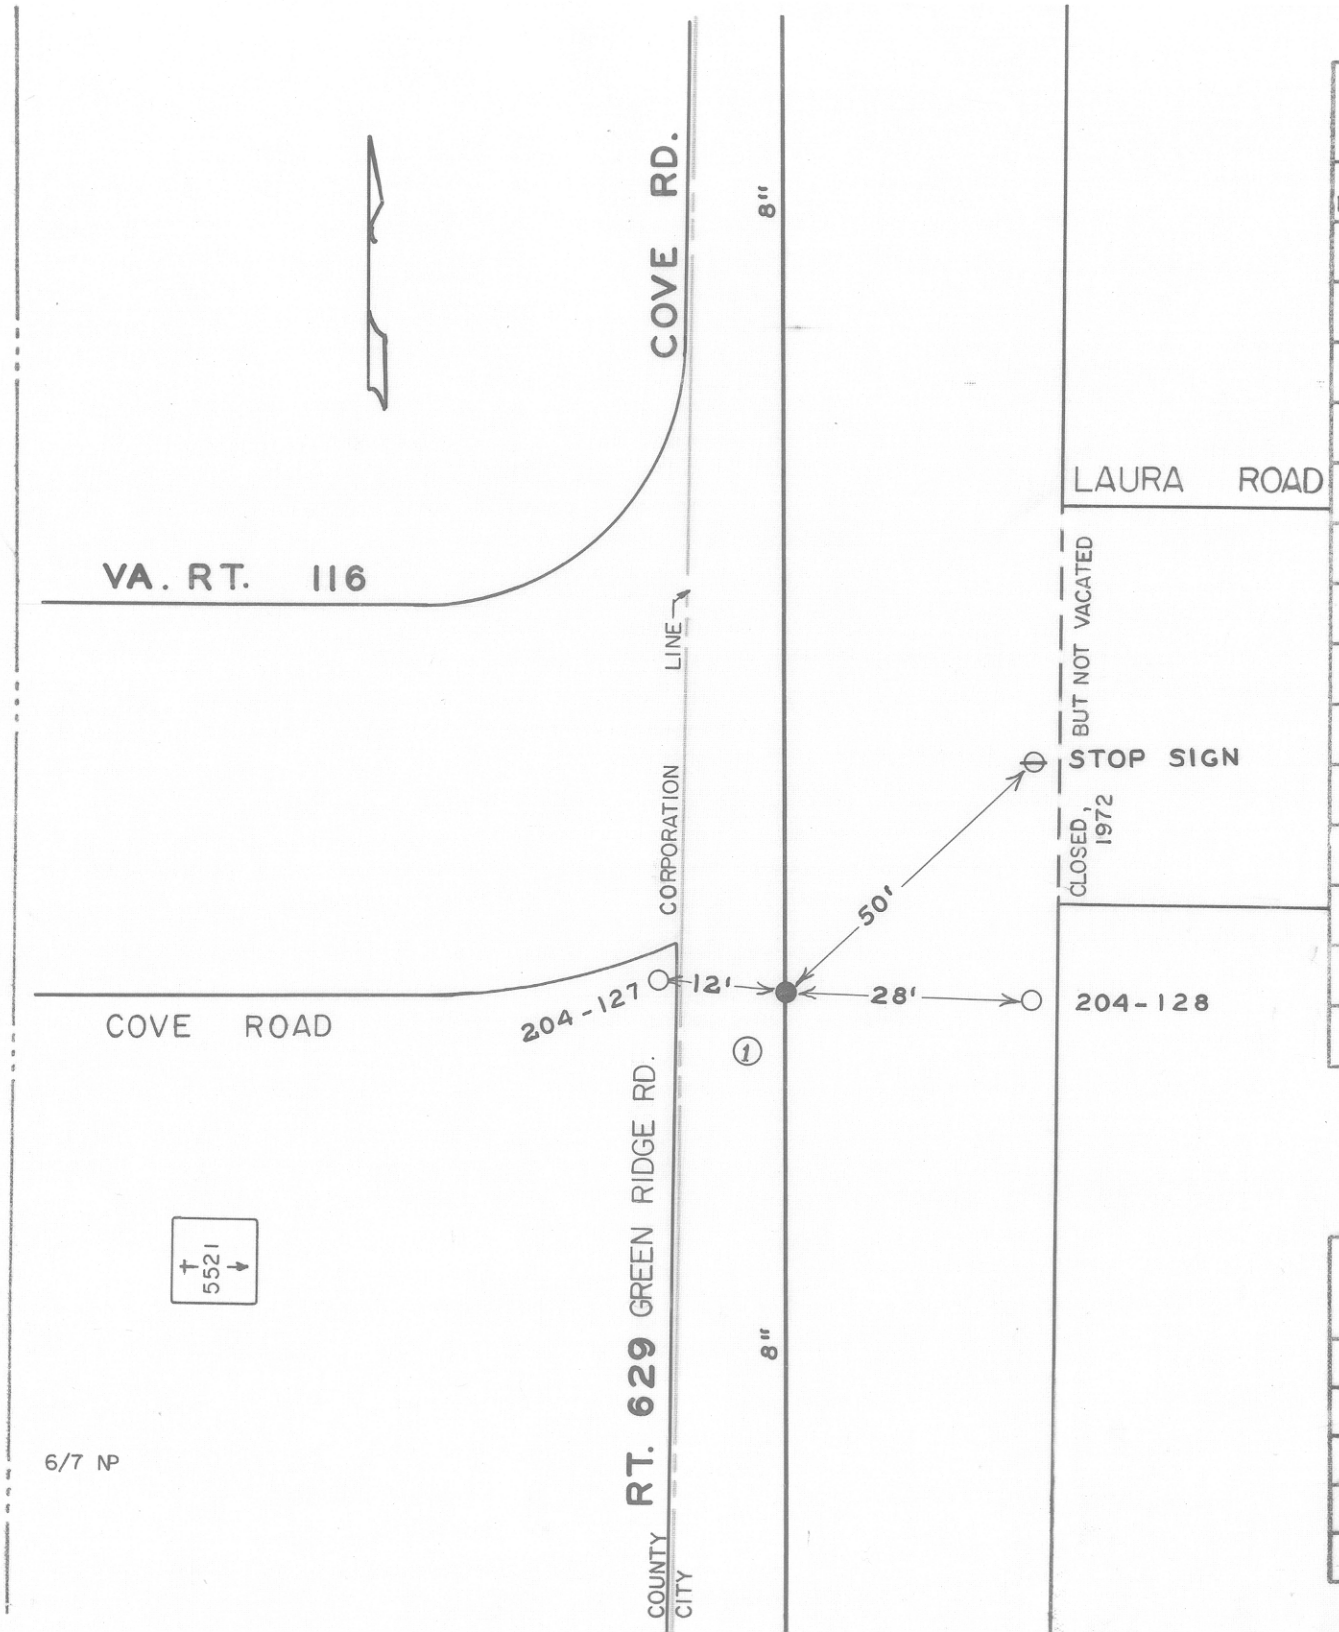

DATE	NO.	SIZE	MAKE	OPEN	TURNS
12-62	1	8"	MUELLER	R	27
	1	0	SPL		

CITY OF ROANOKE — WATER DEPT.

VALVE DIAGRAM

COVE ROAD, ROUTE # 116,

& # 629 - GREEN RIDGE RD.

SEC. MAP COUNTY 478 COUNTY 42; 615 (2)

DATE PAGE NO.