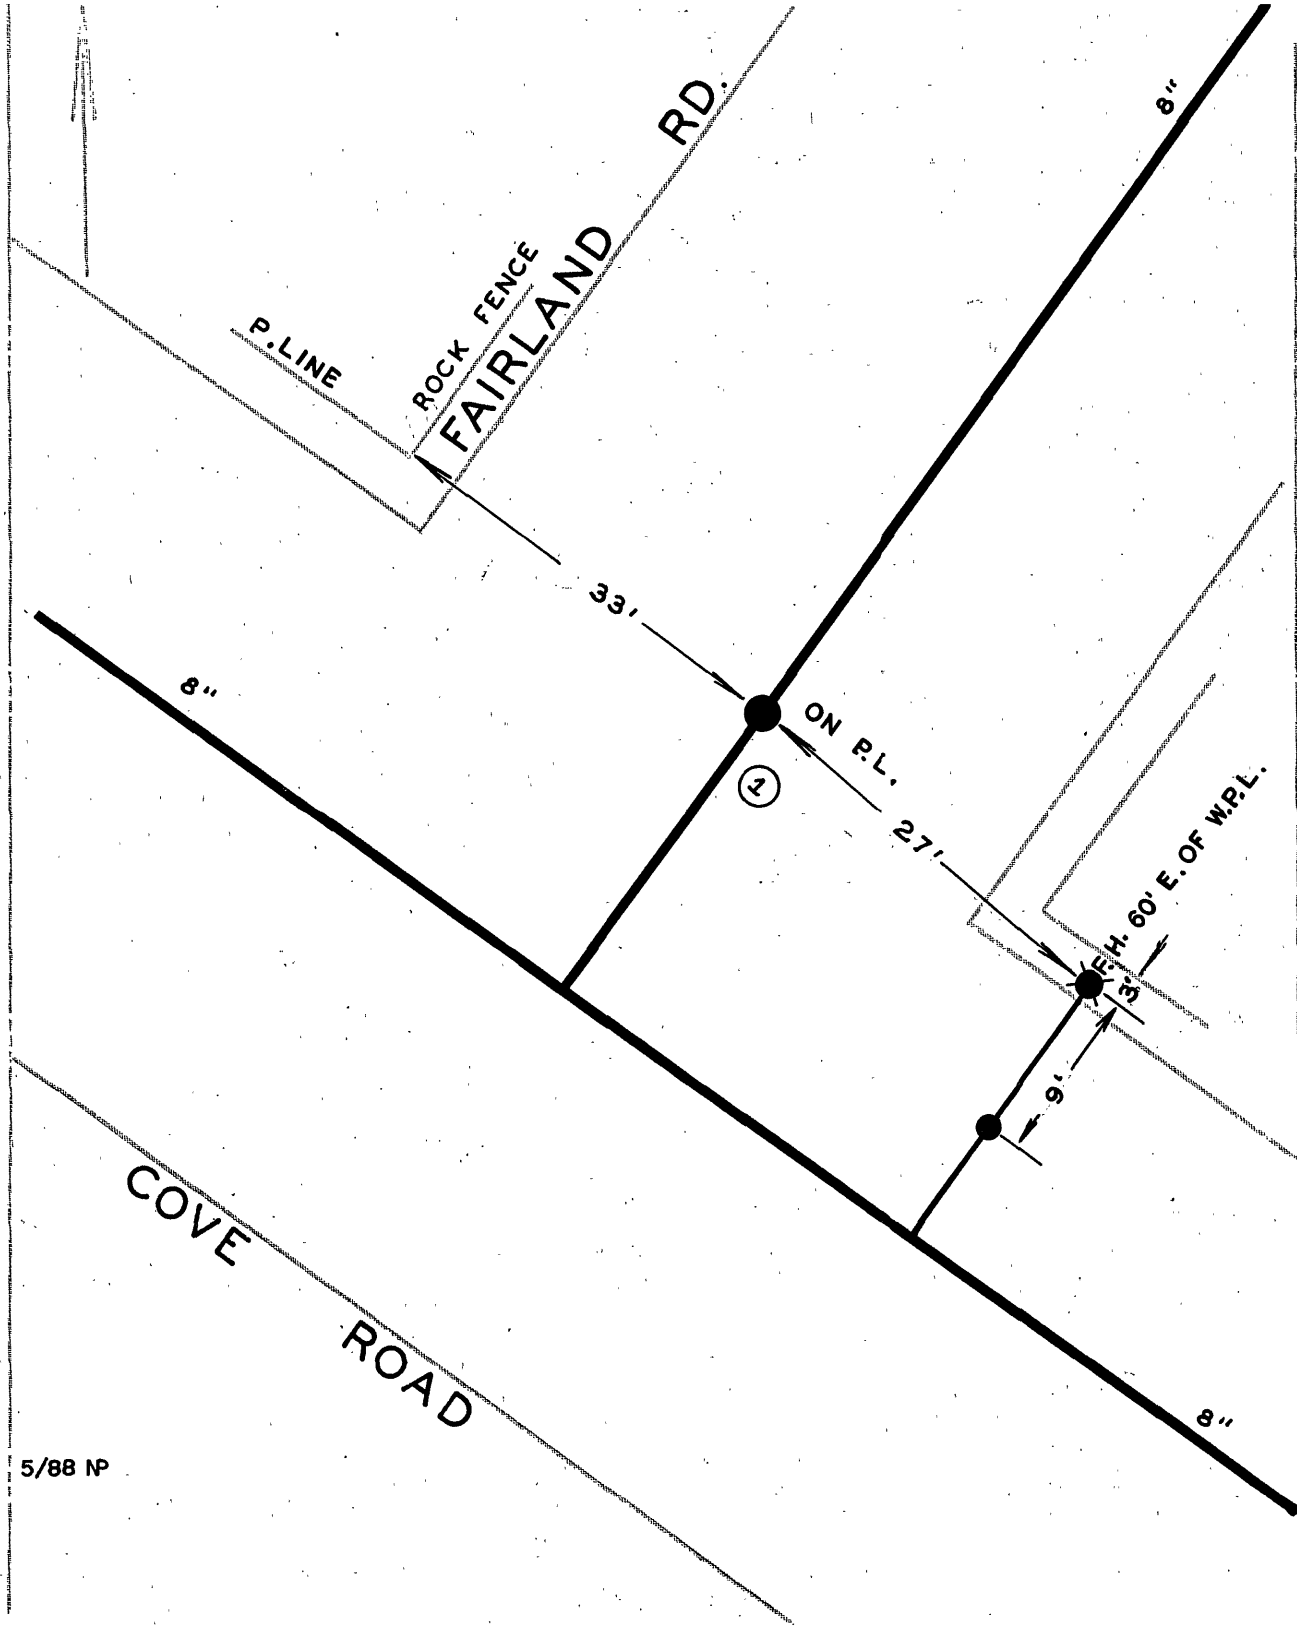

DATE	NO.	SIZE	MAKE	OPEN	TURNS
1950	1	8"	DARLING	R	261/2
	1	0	NPL		

CITY OF ROANOKE—WATER DEP'T

VALVE DIAGRAM

COVE ROAD & FAIRLAND ROAD N.W.

SEC. MAP 247

DATE

PAGE NO N.W.336

5/88 NP