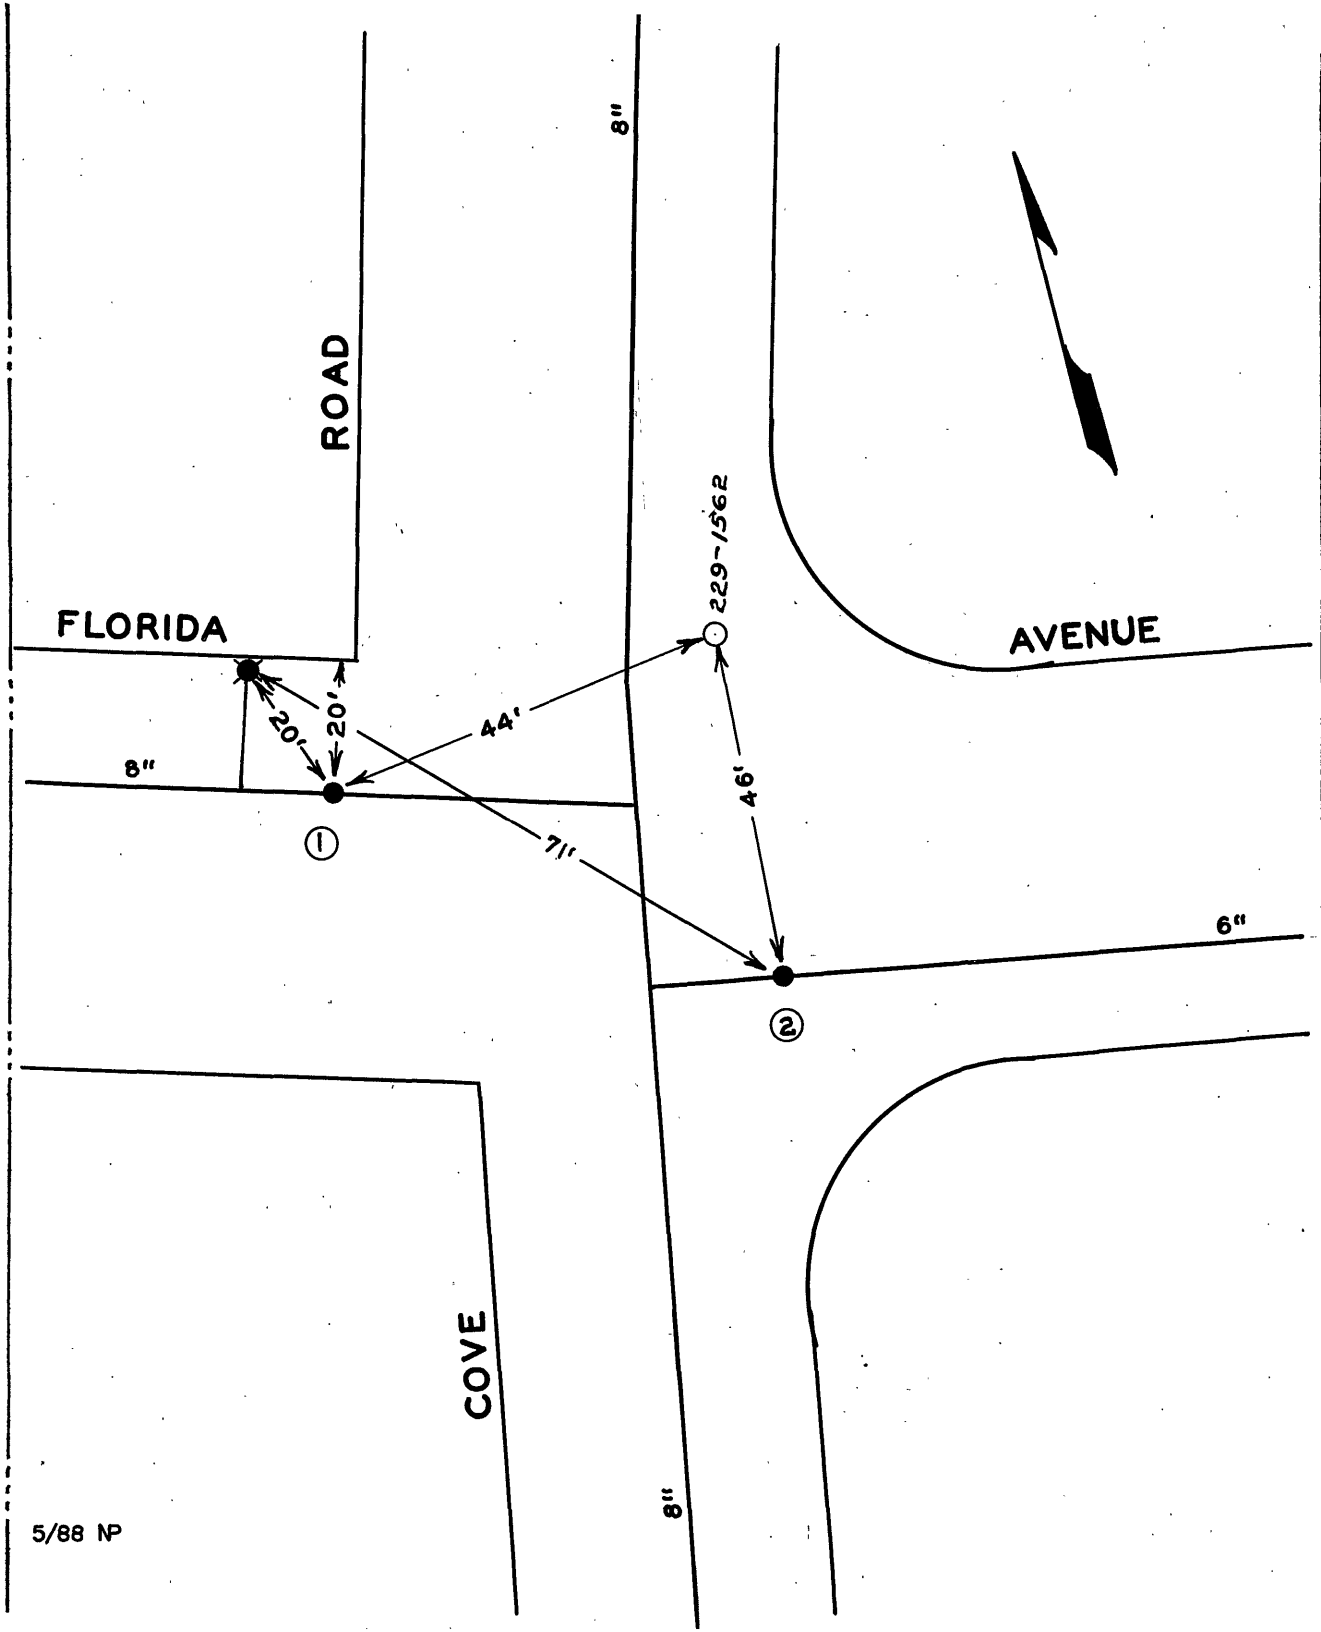

DATE	NO.	SIZE	MAKE	OPEN	TURNS
1949	1	8"	DARLING	R	27
11-63	2	6"	MUELLER	R	
	1	5'W	W.P.L.		
	2	0	E.P.L.		

CITY OF ROANOKE—WATER DEPT.
VALVE DIAGRAM
COVE ROAD & FLORIDA
AVENUE N.W.
SEC. MAP 234
DATE PAGE NO.