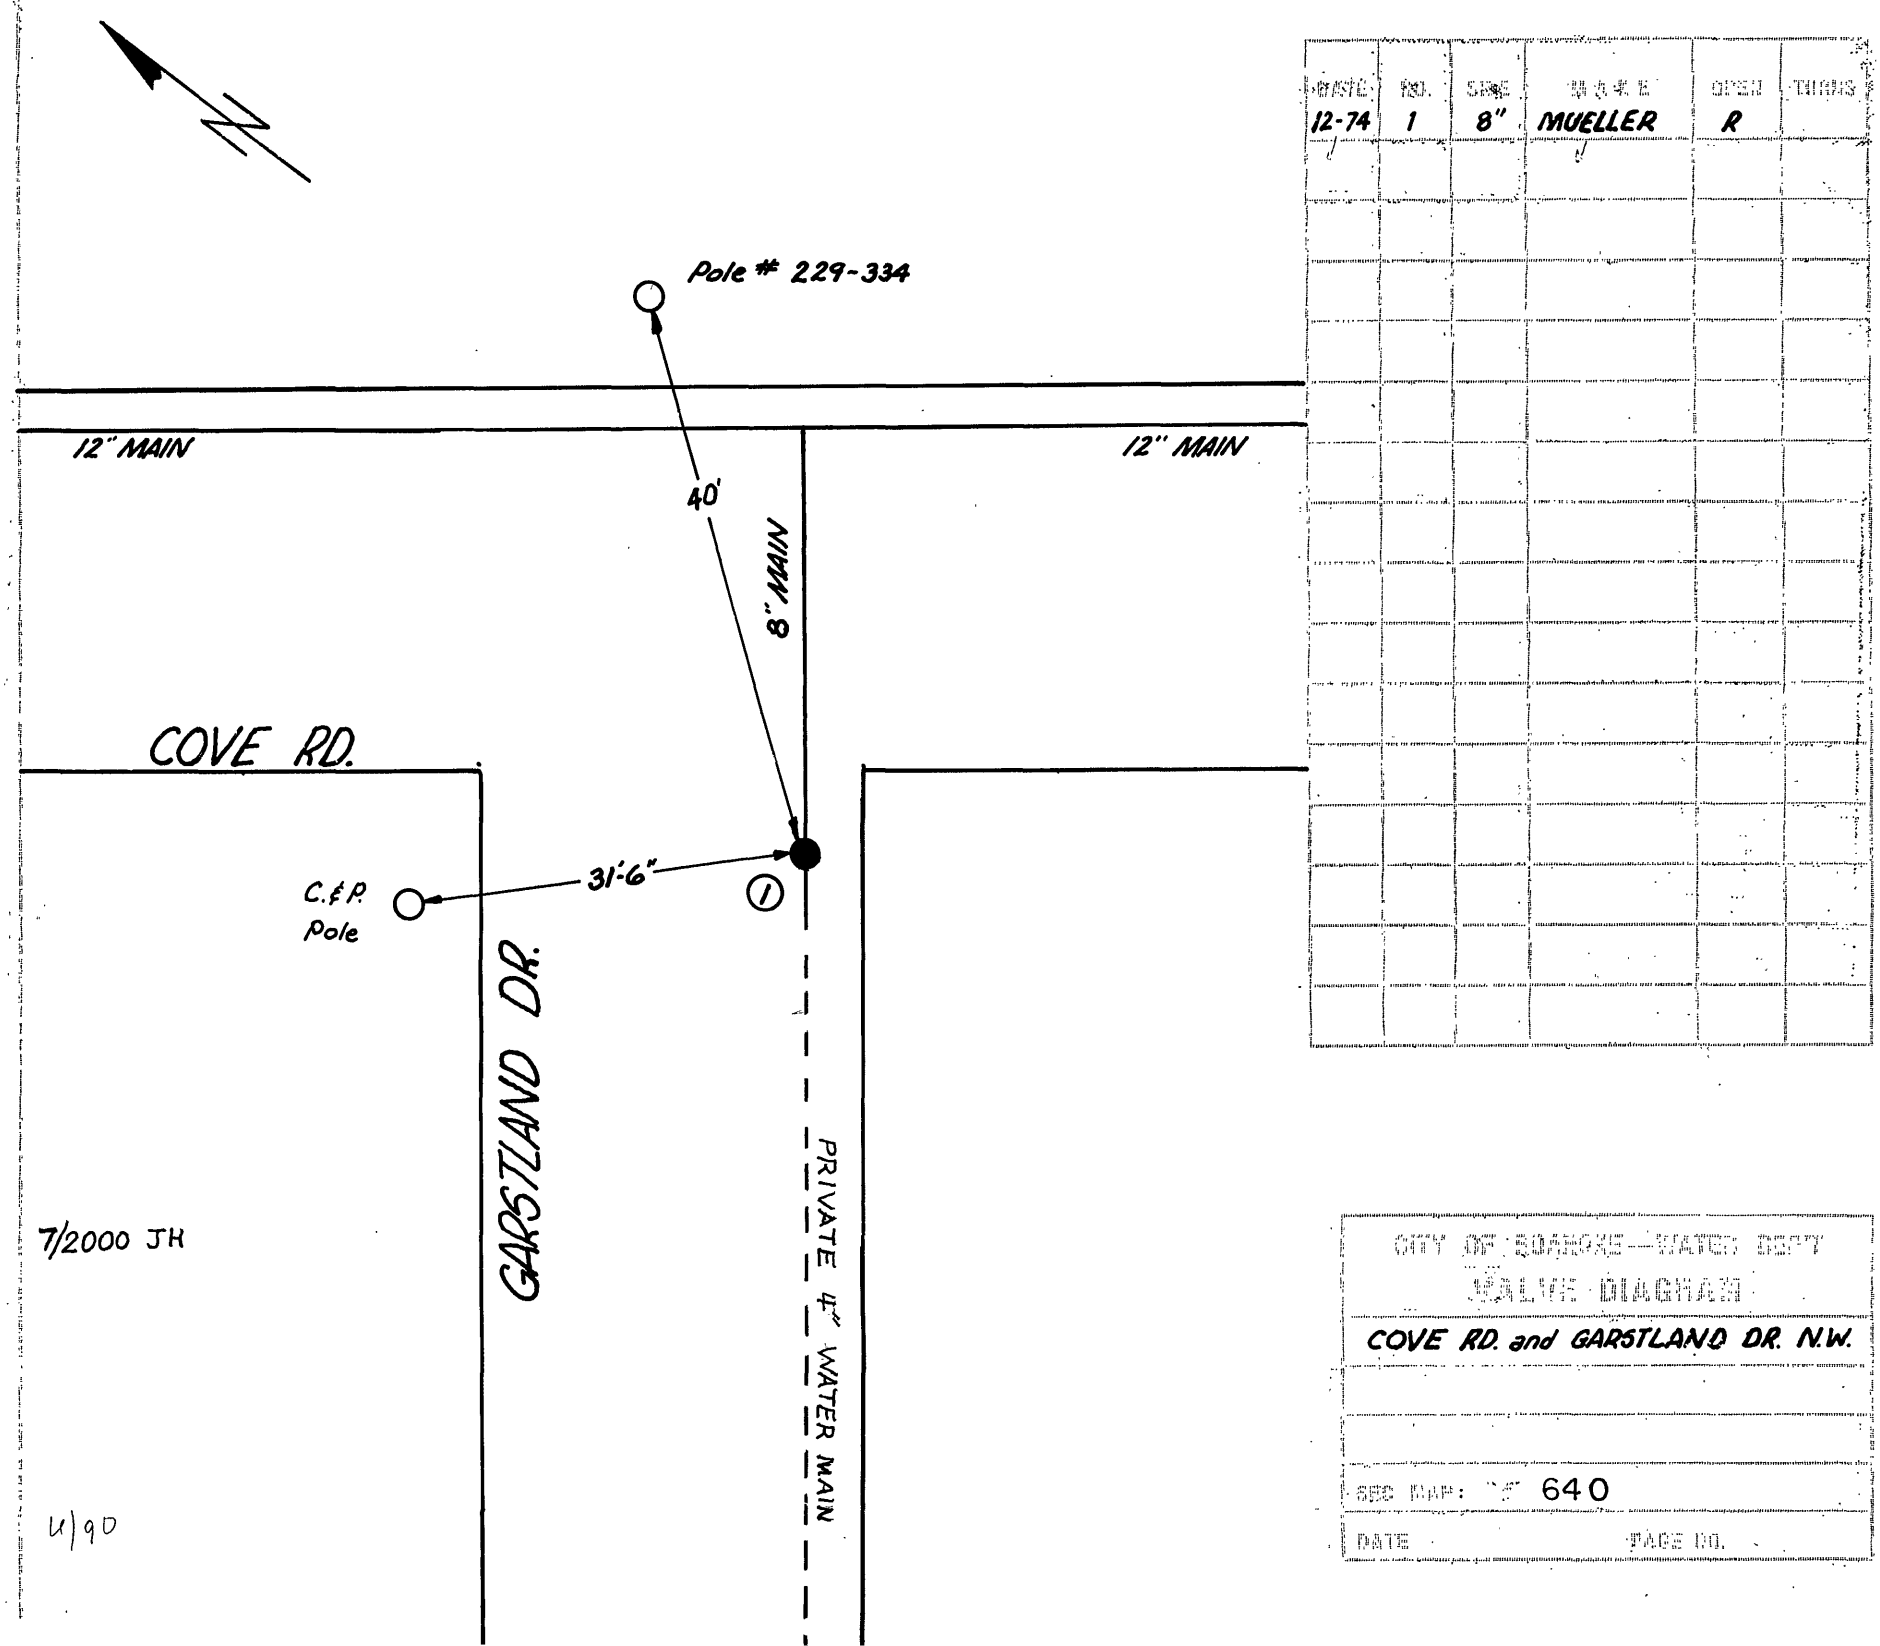

WASTE	NO.	SIZE	MAKE	OPEN	TURNS
12-74	1	8"	MUELLER	R	



COVE RD. and GARSTLAND DR. N.W.

SEE MAP: 640

DATE PAGE NO.