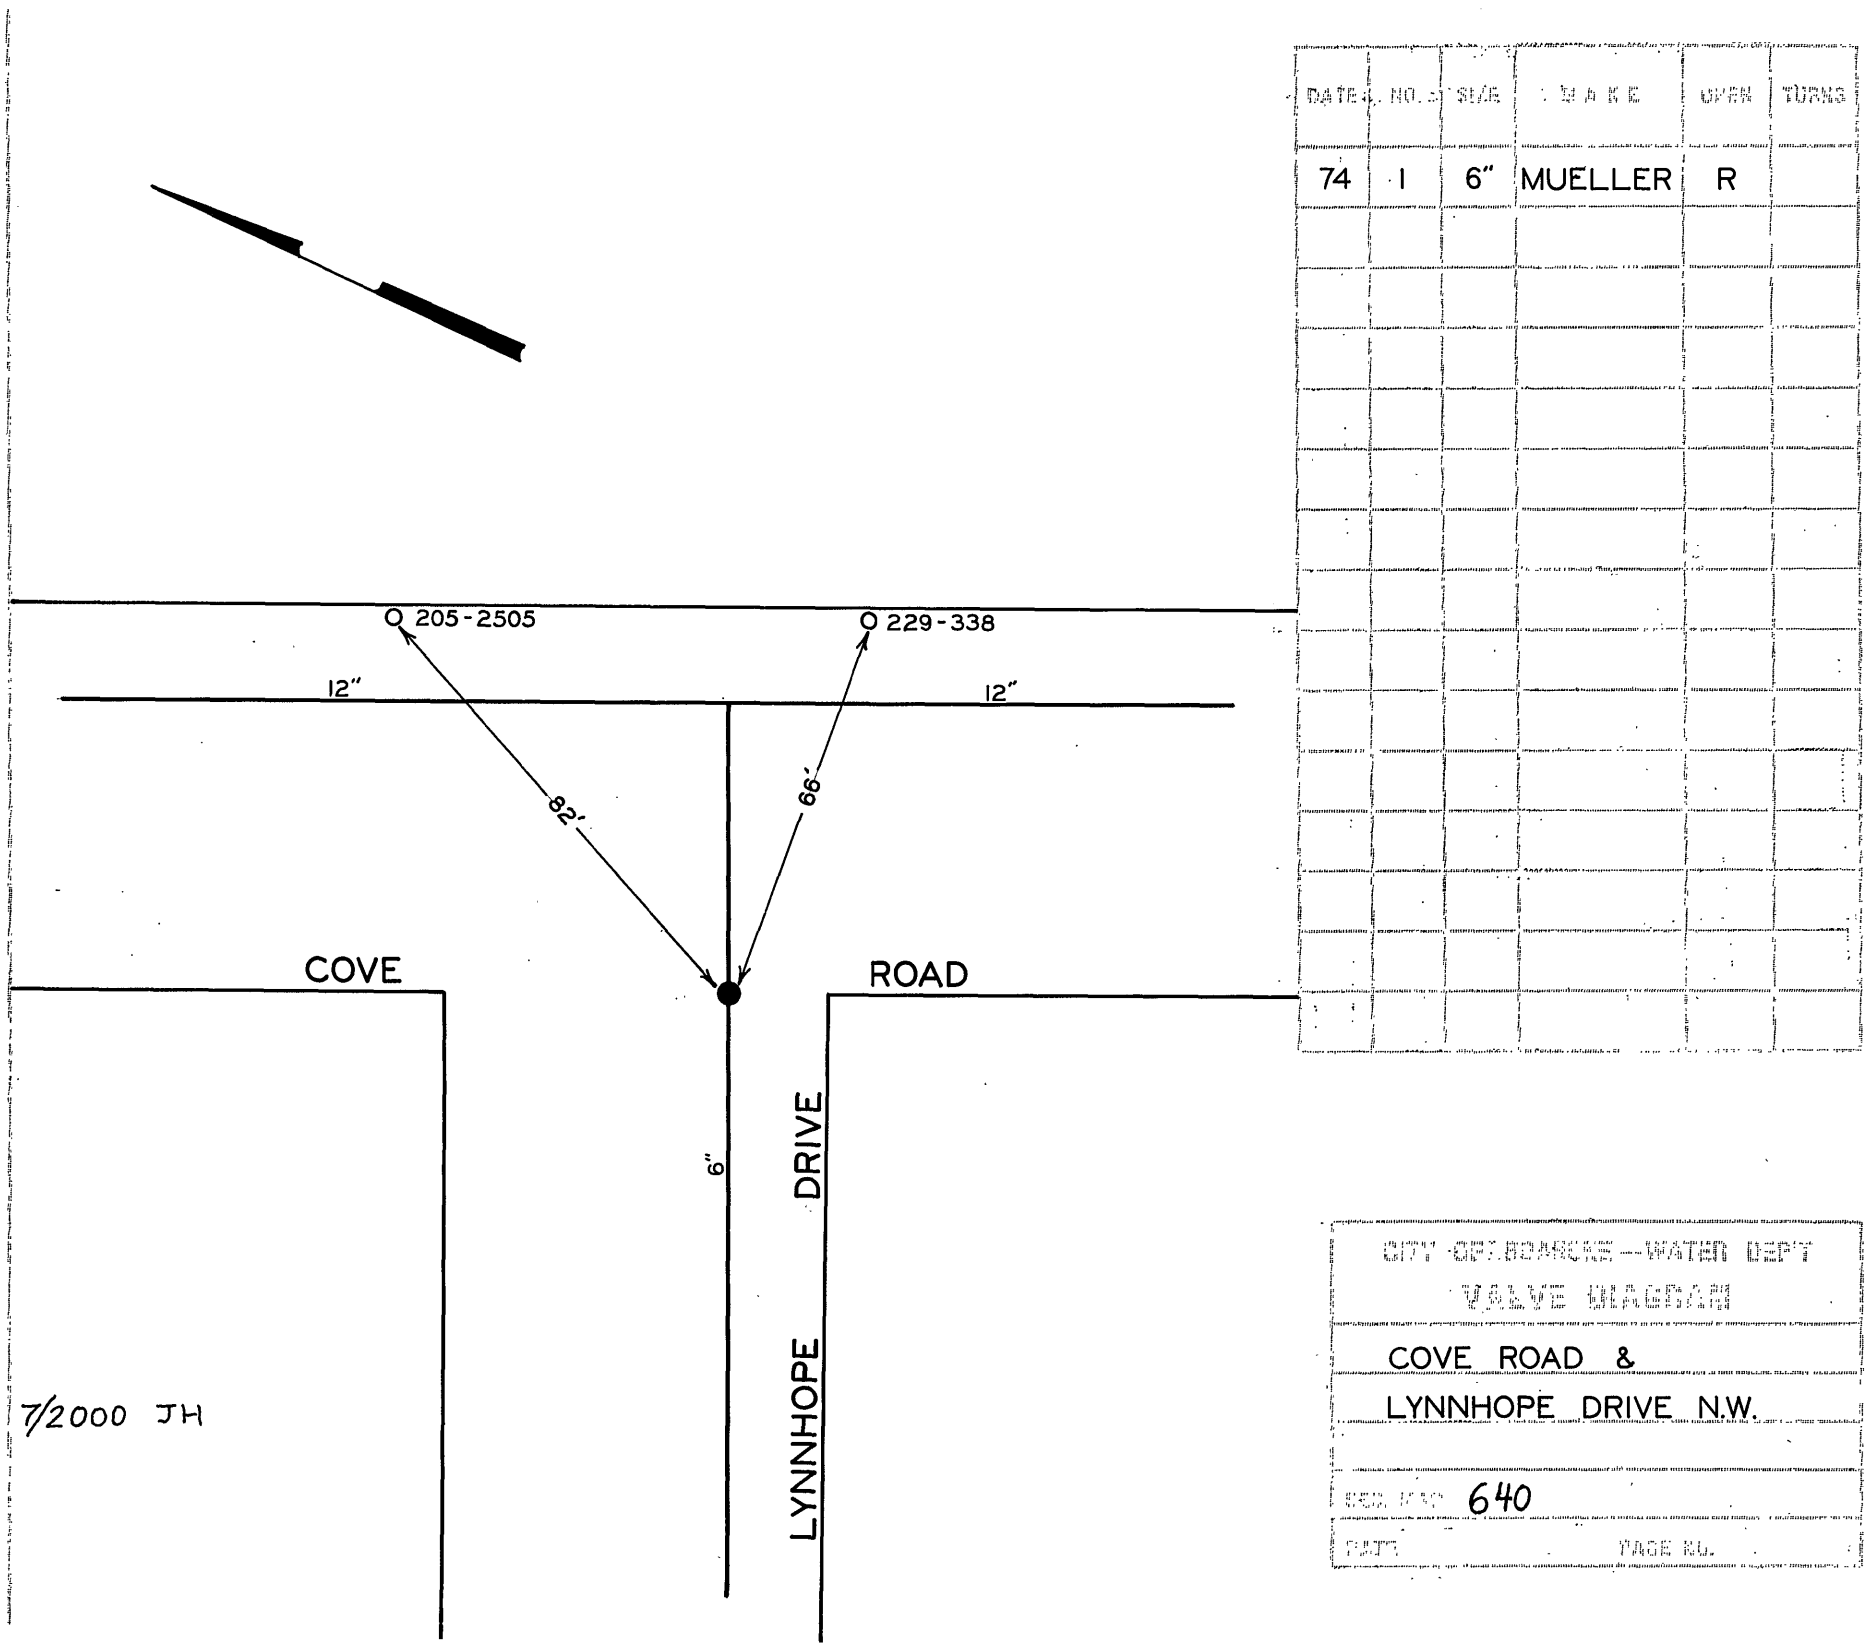

DATE	NO.	SIZE	NAME	OVER	TURNS
74	1	6"	MUELLER	R	

CITY OF BRIDGES — WATER DEPT.

VALVE DIAGRAM

COVE ROAD &

LYNNHOPE DRIVE N.W.

SEC. 640

CITY PAGE NO.