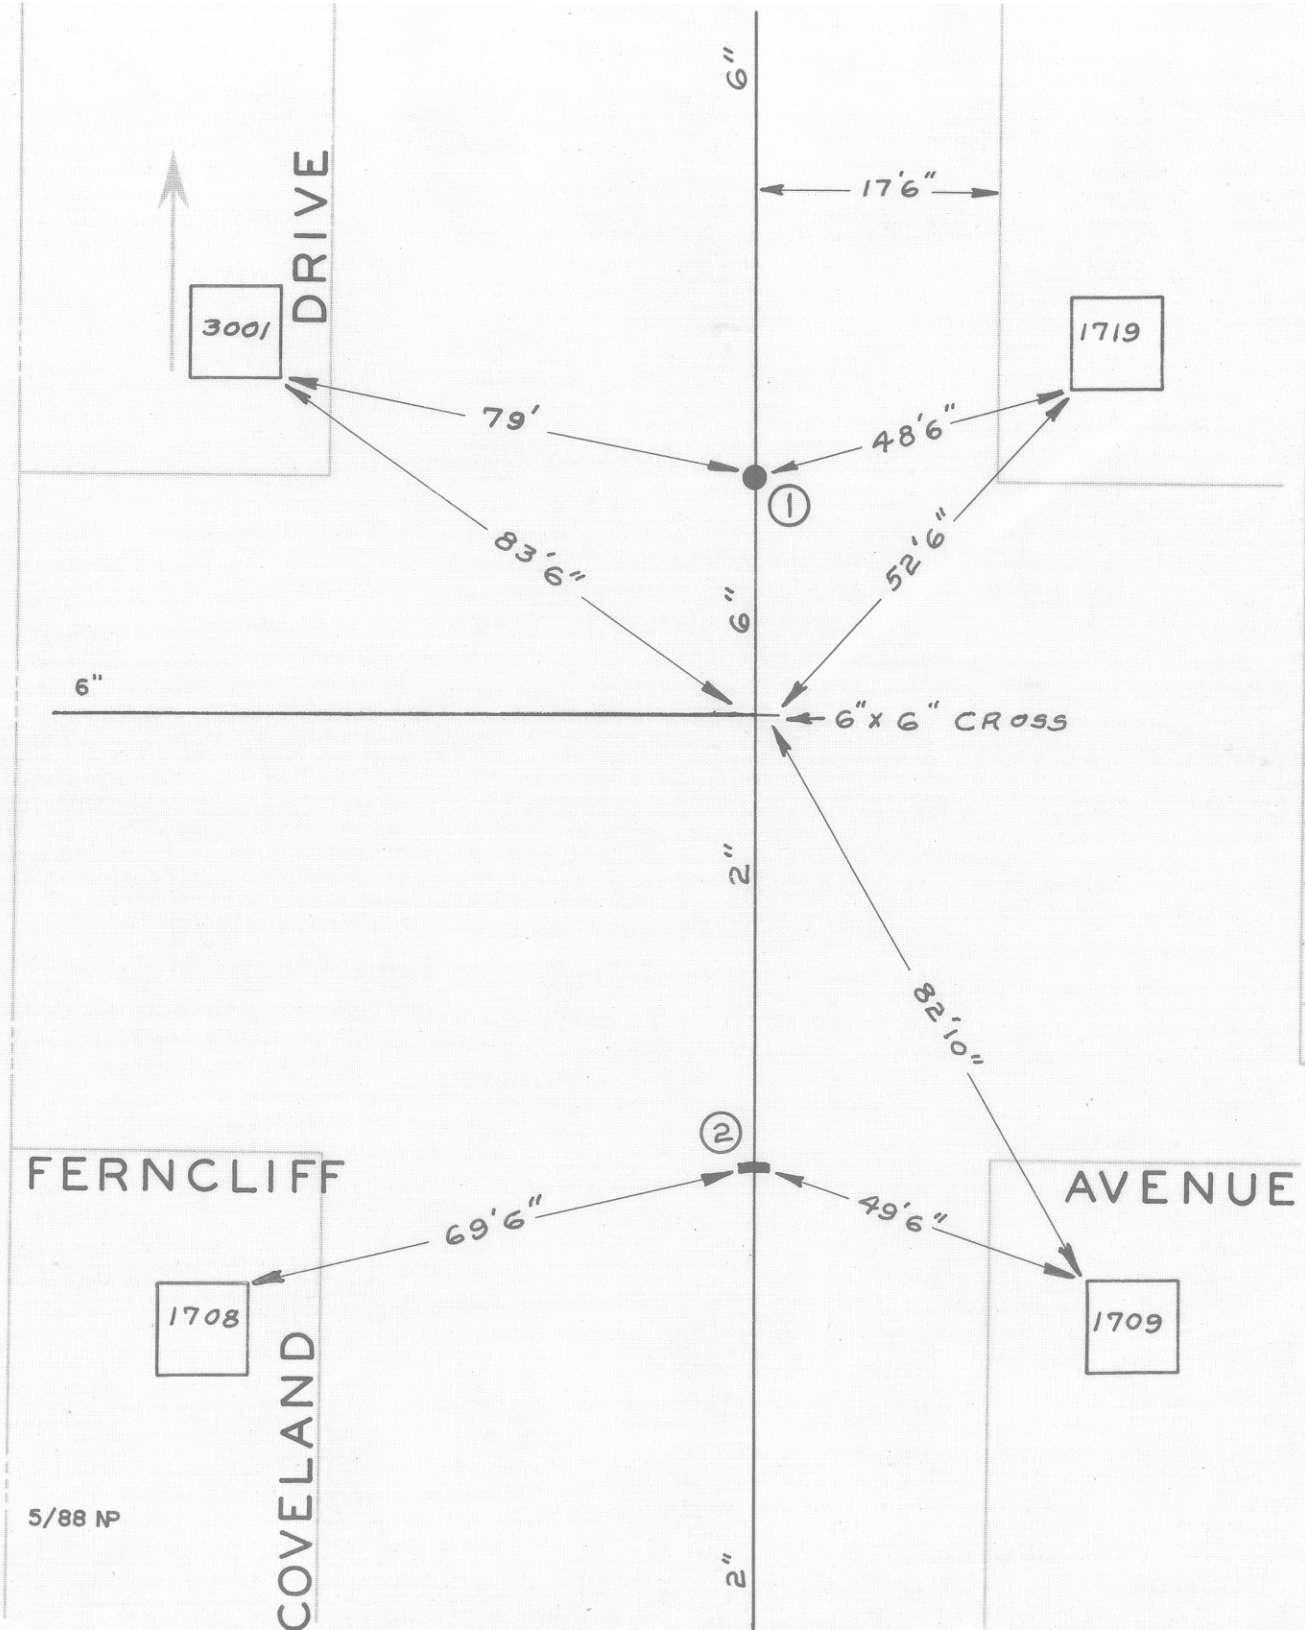

DATE	NO.	SIZE	MAKE	OPEN	TURNS
'58	1	6"	MUELLER	R	
'58	2	2"	DARLING	R	
	1	0	NPL		
	2	0	SPL		

CITY OF ROANOKE — WATER DEP'T

VALVE DIAGRAM

COVELAND DRIVE &

FERNCLIFF AVE. N.W.

SEC. MAP 248

DATE PAGE NO.