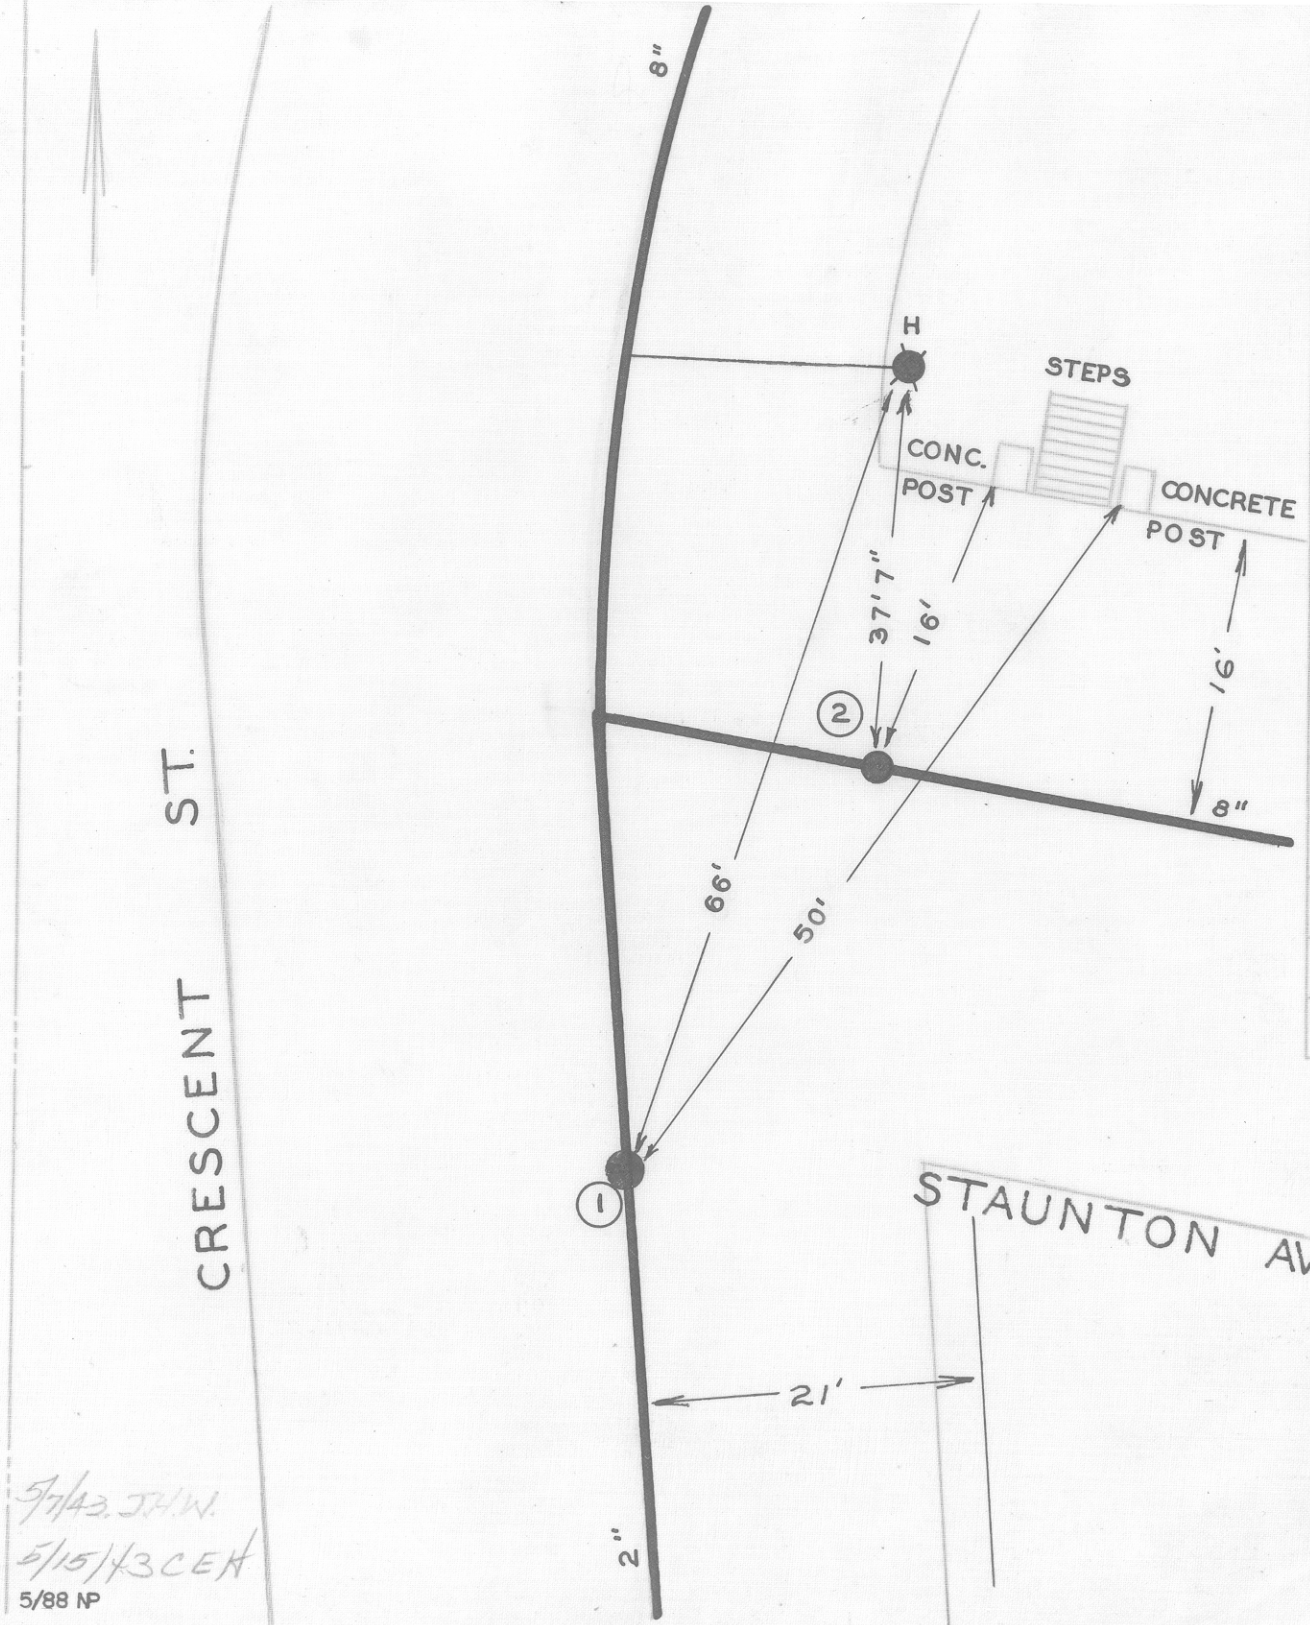

DATE	NO.	SIZE	MAKE	OPEN	TURNS
1942	1	2"		R	6
1942	2	8"		R	28 1/2
	1	0	SPL		
	2	0	EPL		

CITY OF ROANOKE — WATER DEP'T

VALVE DIAGRAM

CRESCENT ST. &

STAUNTON AVE. N.W.

SEC. MAP 243

DATE

PAGE NO NW252

5/7/43. J.H.W.

5/15/43 C.E.H

5/88 NP