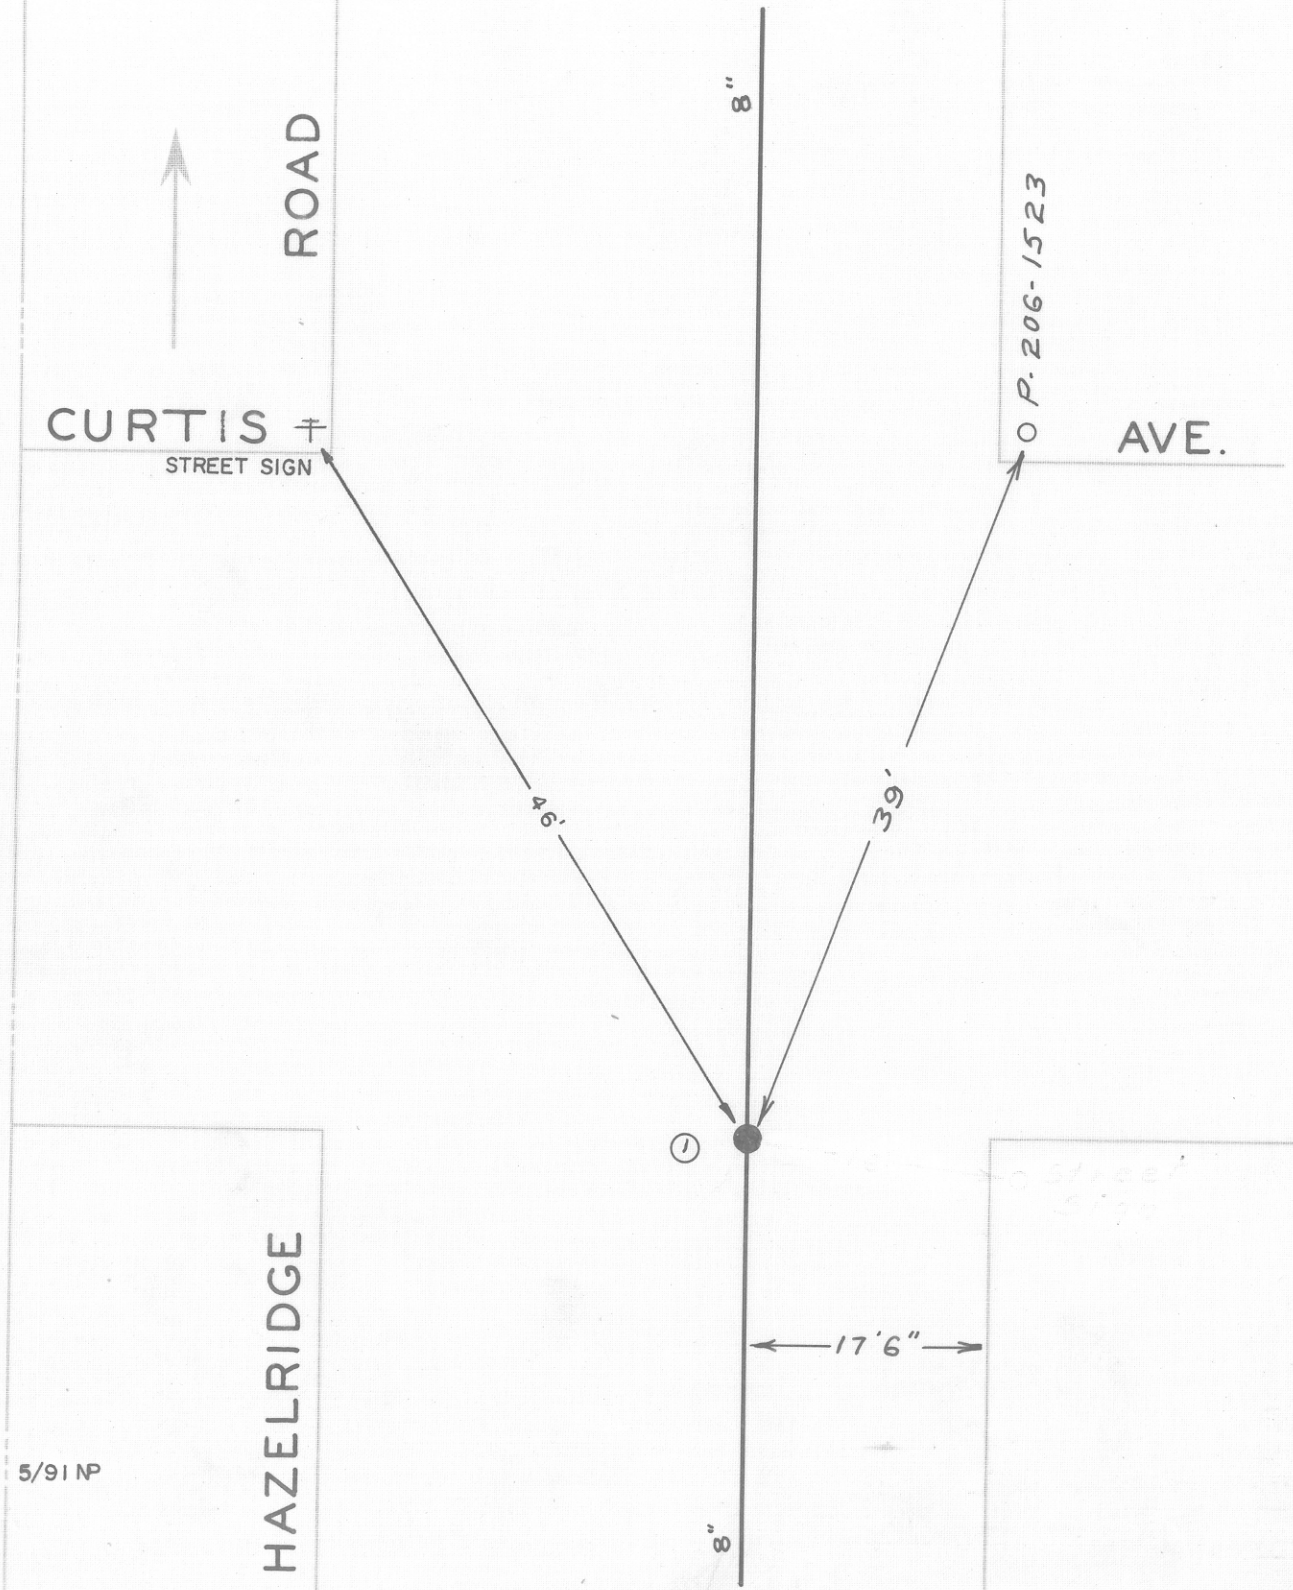

DATE	NO.	SIZE	MAKE	OPEN	TURNS
1956	1	8"	DARLING	R	
	1	0	SPL		

CITY OF ROANOKE—WATER DEP'T

VALVE DIAGRAM

CURTIS AVE. &

HAZELRIDGE RD. N. W.

SEC. MAP 220

DATE PAGE NO.