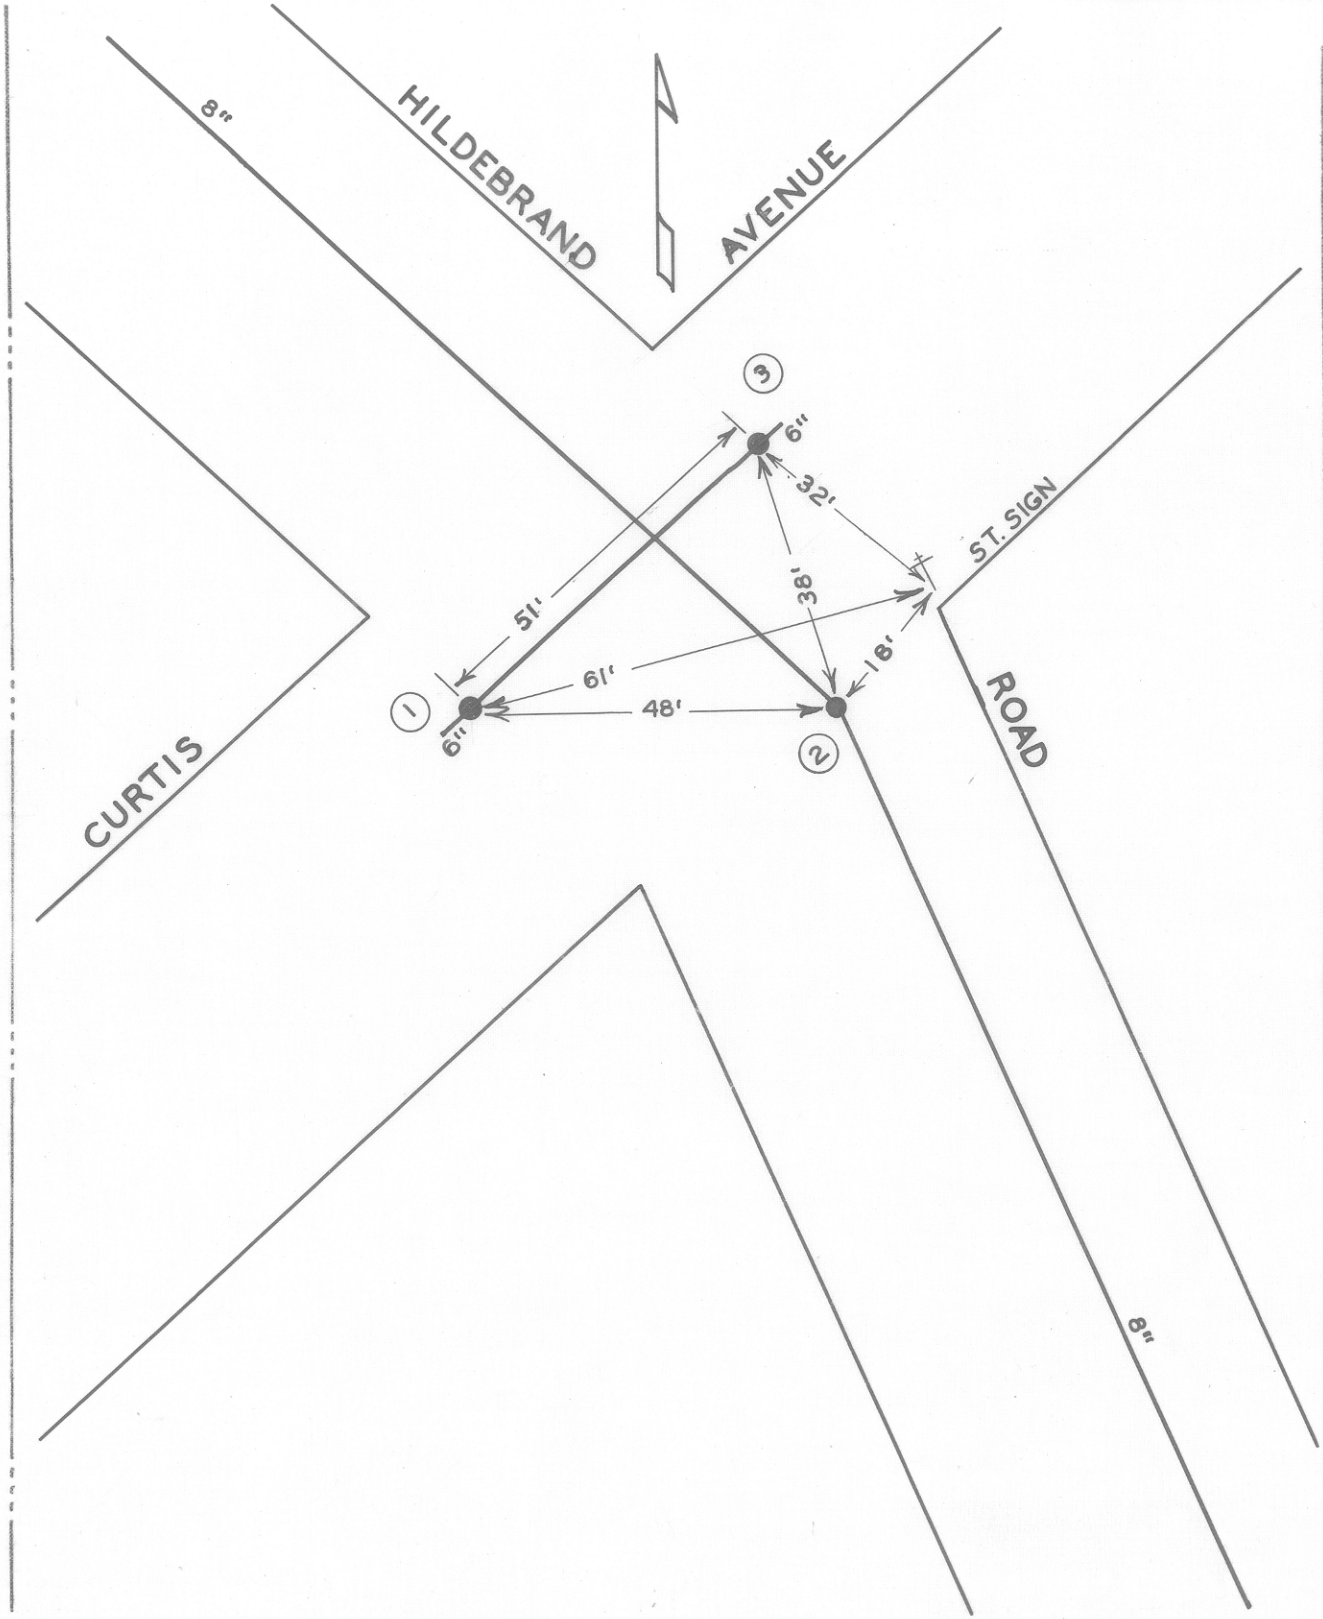

DATE	NO.	SIZE	MAKE	OPEN	TURNS
11-61	1	6"	DARLING	R	
11-61	2	8"	DARLING	R	
11-61	3	6"	DARLING	R	
	1	0	WPL		
	2	0	SPL		
	3	0	EPL		

CITY OF ROANOKE — WATER DEPT.

VALVE DIAGRAM

CURTIS AVENUE &

HILDEBRAND ROAD N.W.

SEC. MAP 220

DATE PAGE NO.