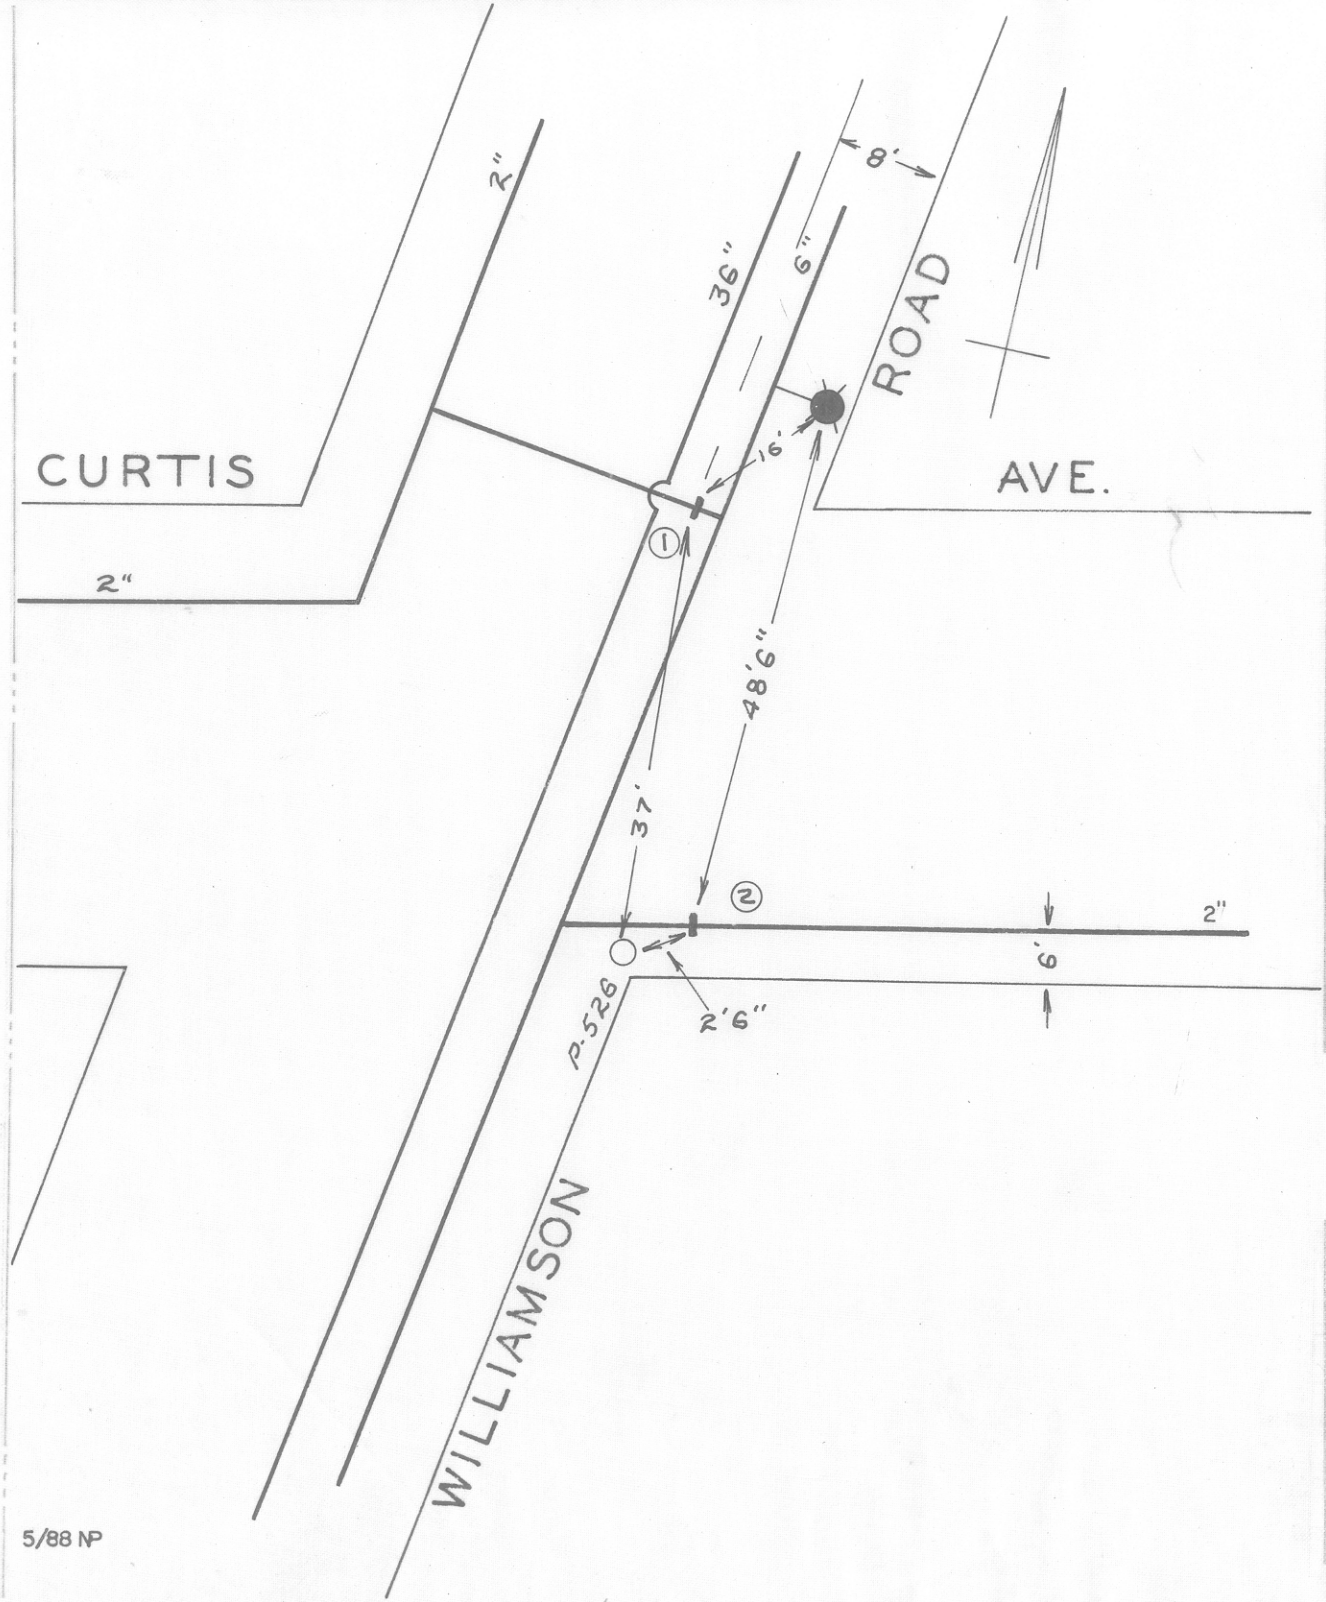

DATE	NO.	SIZE	MAKE	OPEN	TURNS
1951	1	2"			
1951	2	2"			
	1	0	NPL		
	2	3'-E	EPL		

CITY OF ROANOKE — WATER DEPT.

VALVE DIAGRAM

CURTIS AVE. & WILLIAMSON ROAD N. W.

SEC. MAP 219

DATE W.R. PAGE NO.

5/88 NP

"IMPERIAL" TRACING CLOTH
K & E CO., N. Y.