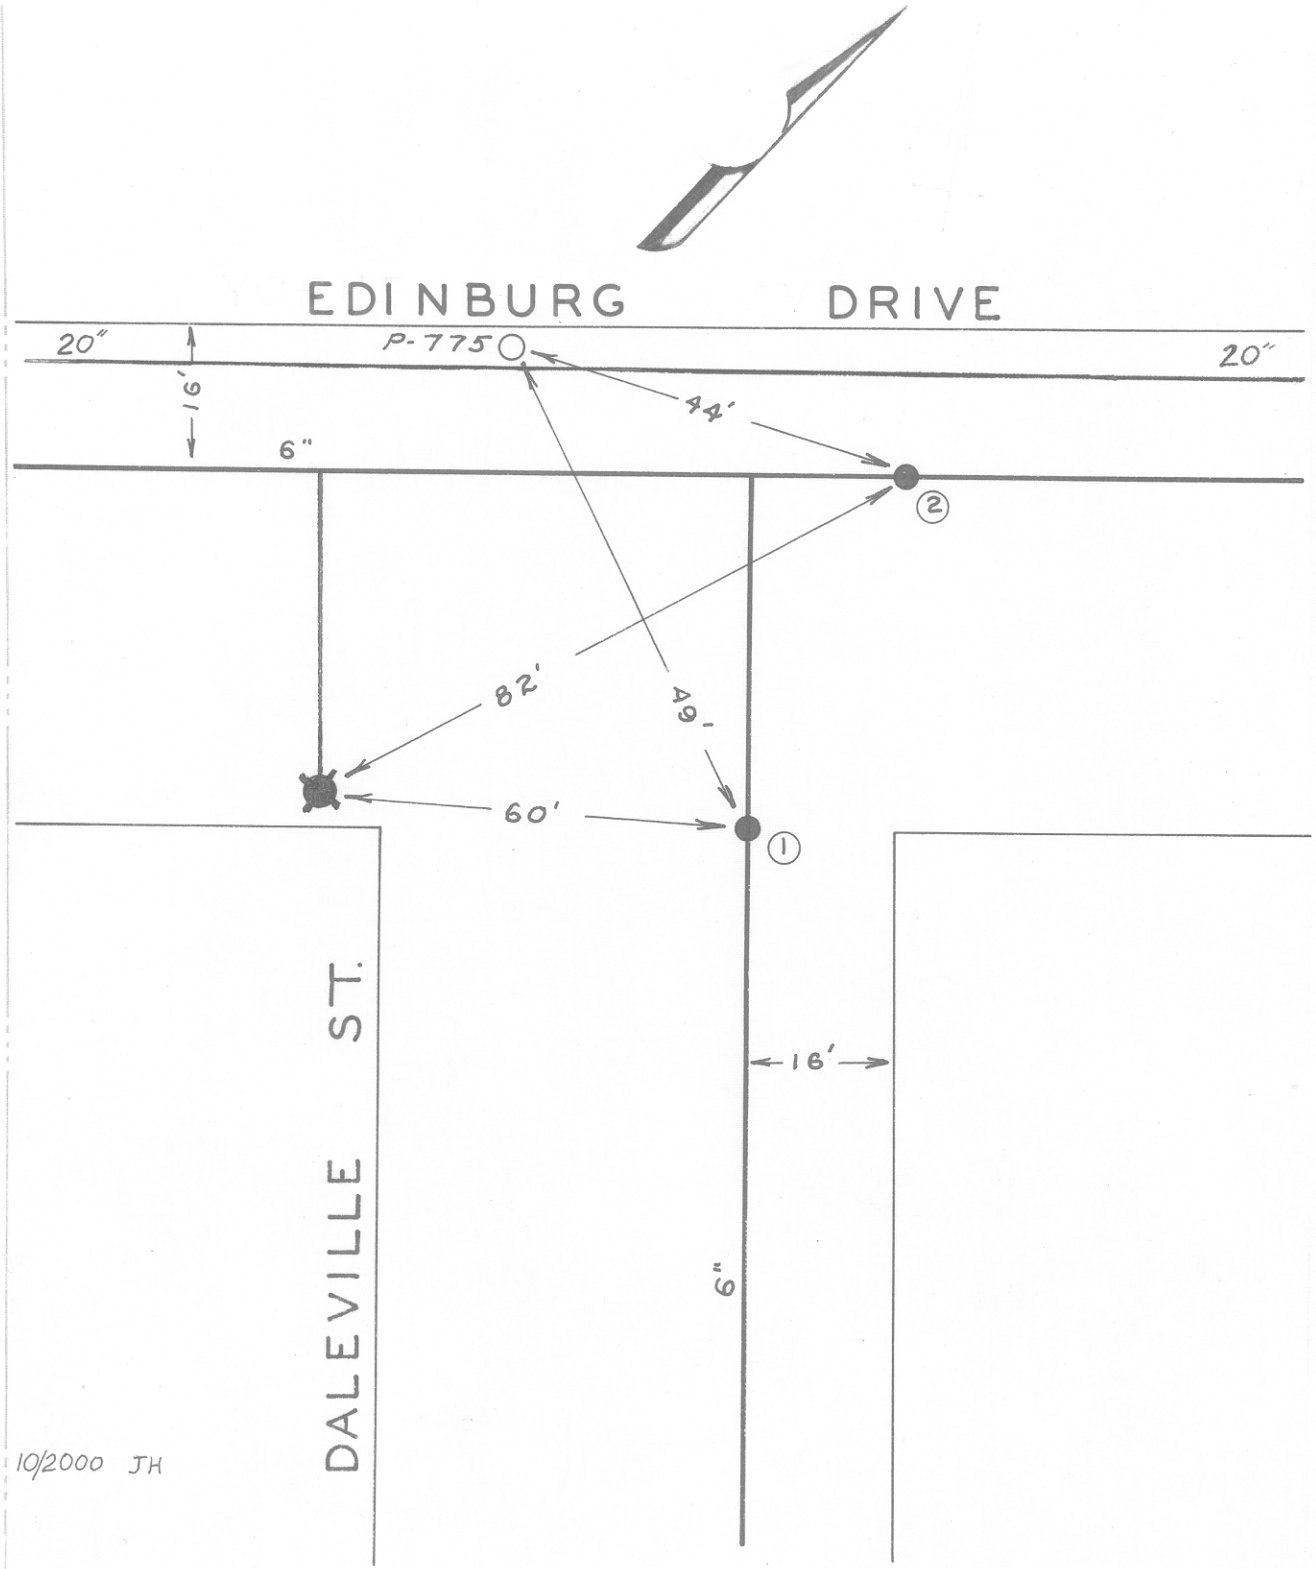

DATE	NO.	SIZE	MAKE	OPEN	TURNS
1953	1	6"		R	
1953	2	6"		R	
	1	0	SPL		
	2	0	EPL		

CITY OF ROANOKE – WATER DEPT.

VALVE DIAGRAM

DALEVILLE ST. &

EDINBURG DR.

SEC. MAP 228 NW

DATE PAGE NO.

10/2000 JH

IMPERIAL TRACING CLOTH
K & E CO., N.Y.