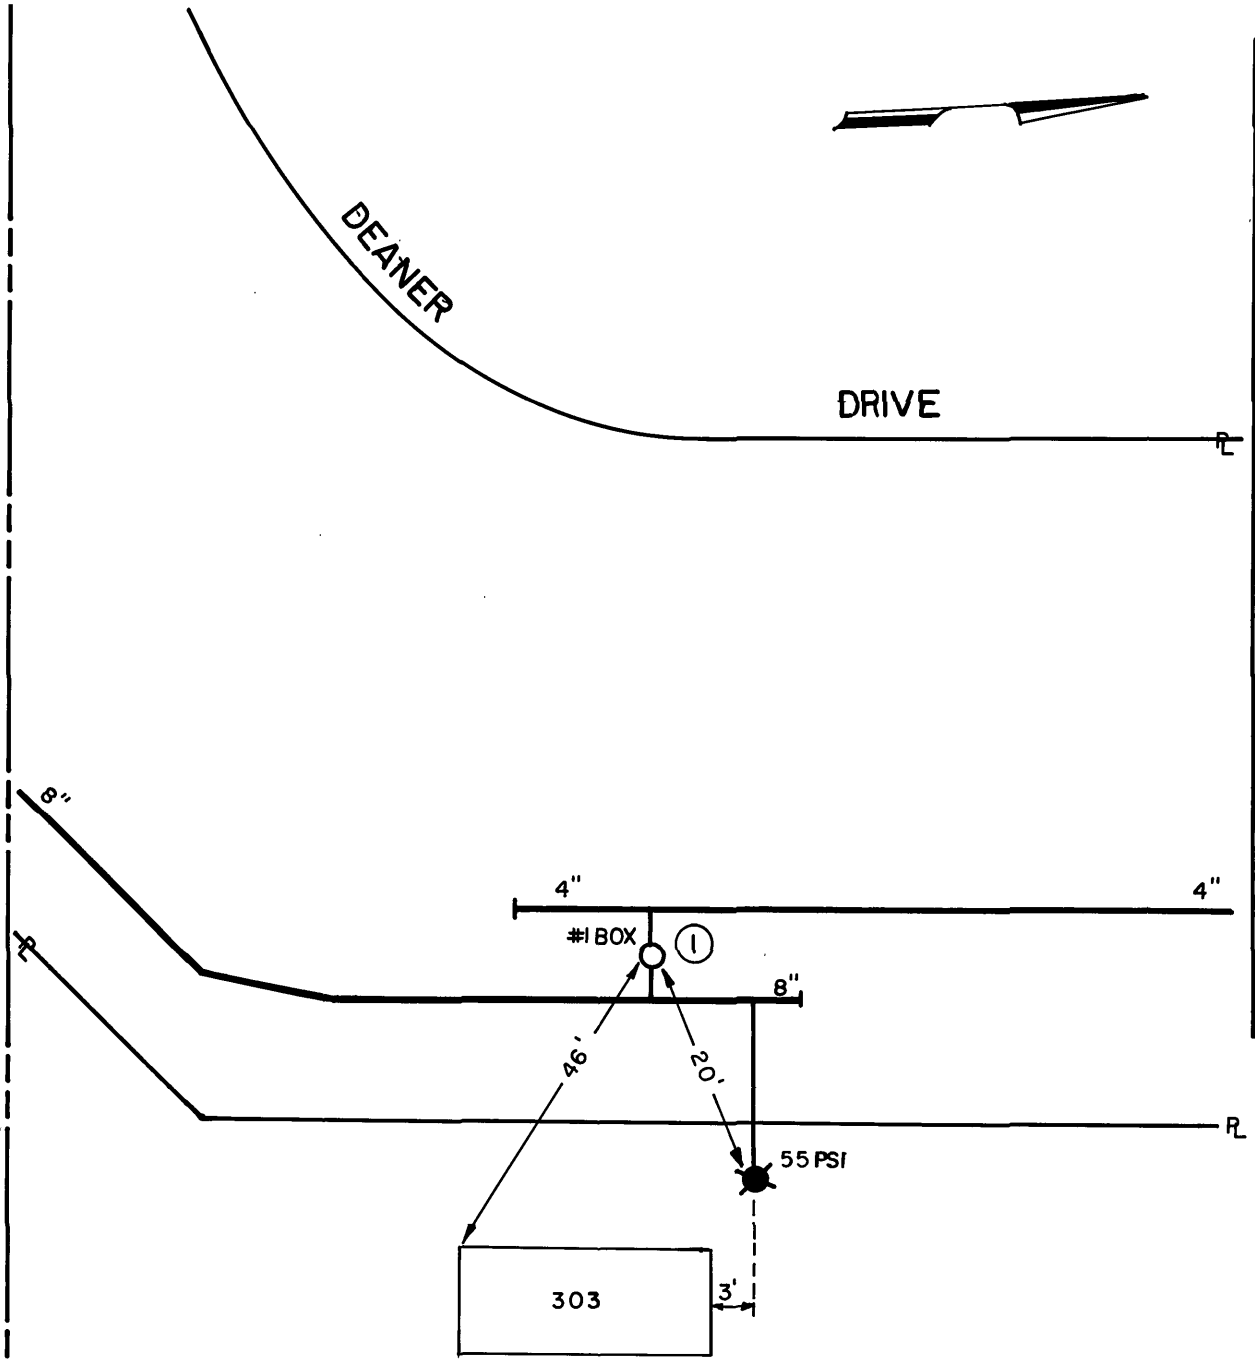

DATE	NO.	SIZE	MAKE	OPEN	TURNS
1991	1	4"	MUELLER	R	

CITY OF ROANOKE - WATER DEP'T.

VALVE DIAGRAM

303 DEANER DRIVE

SEC. MAP 606 N.W.

DATE: PAGE NO.

10/98 NP

10/2000 JH