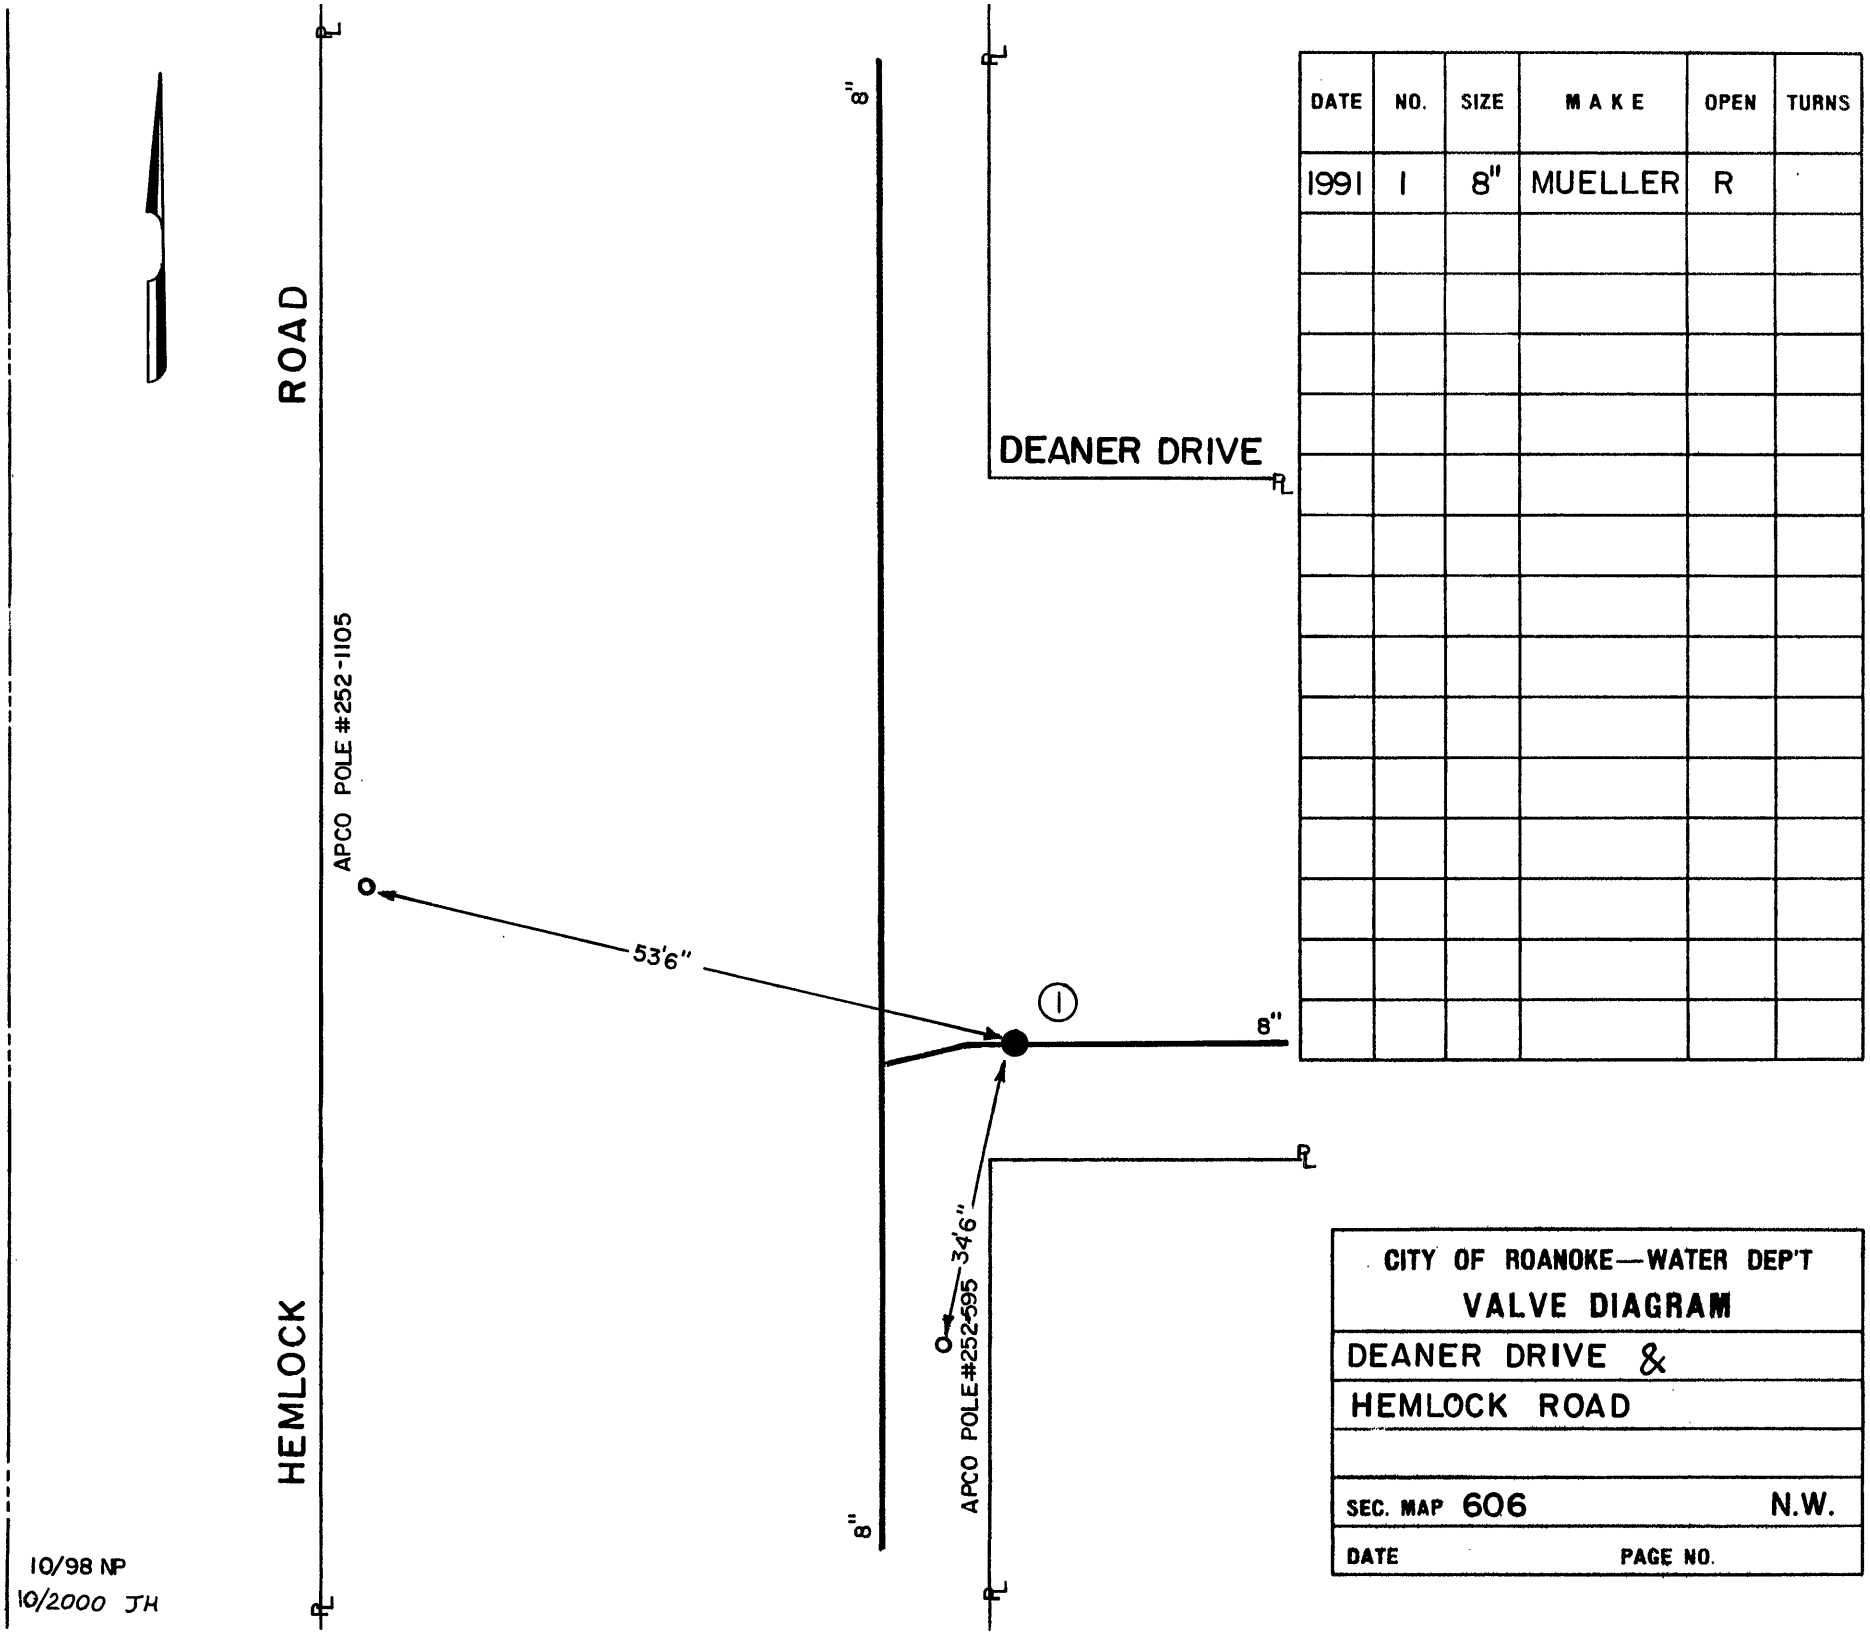

DATE	NO.	SIZE	MAKE	OPEN	TURNS
1991	1	8"	MUELLER	R	

CITY OF ROANOKE—WATER DEP'T

VALVE DIAGRAM

DEANER DRIVE &

HEMLOCK ROAD

SEC. MAP 606 N.W.

DATE PAGE NO.

10/98 NP
10/2000 JH