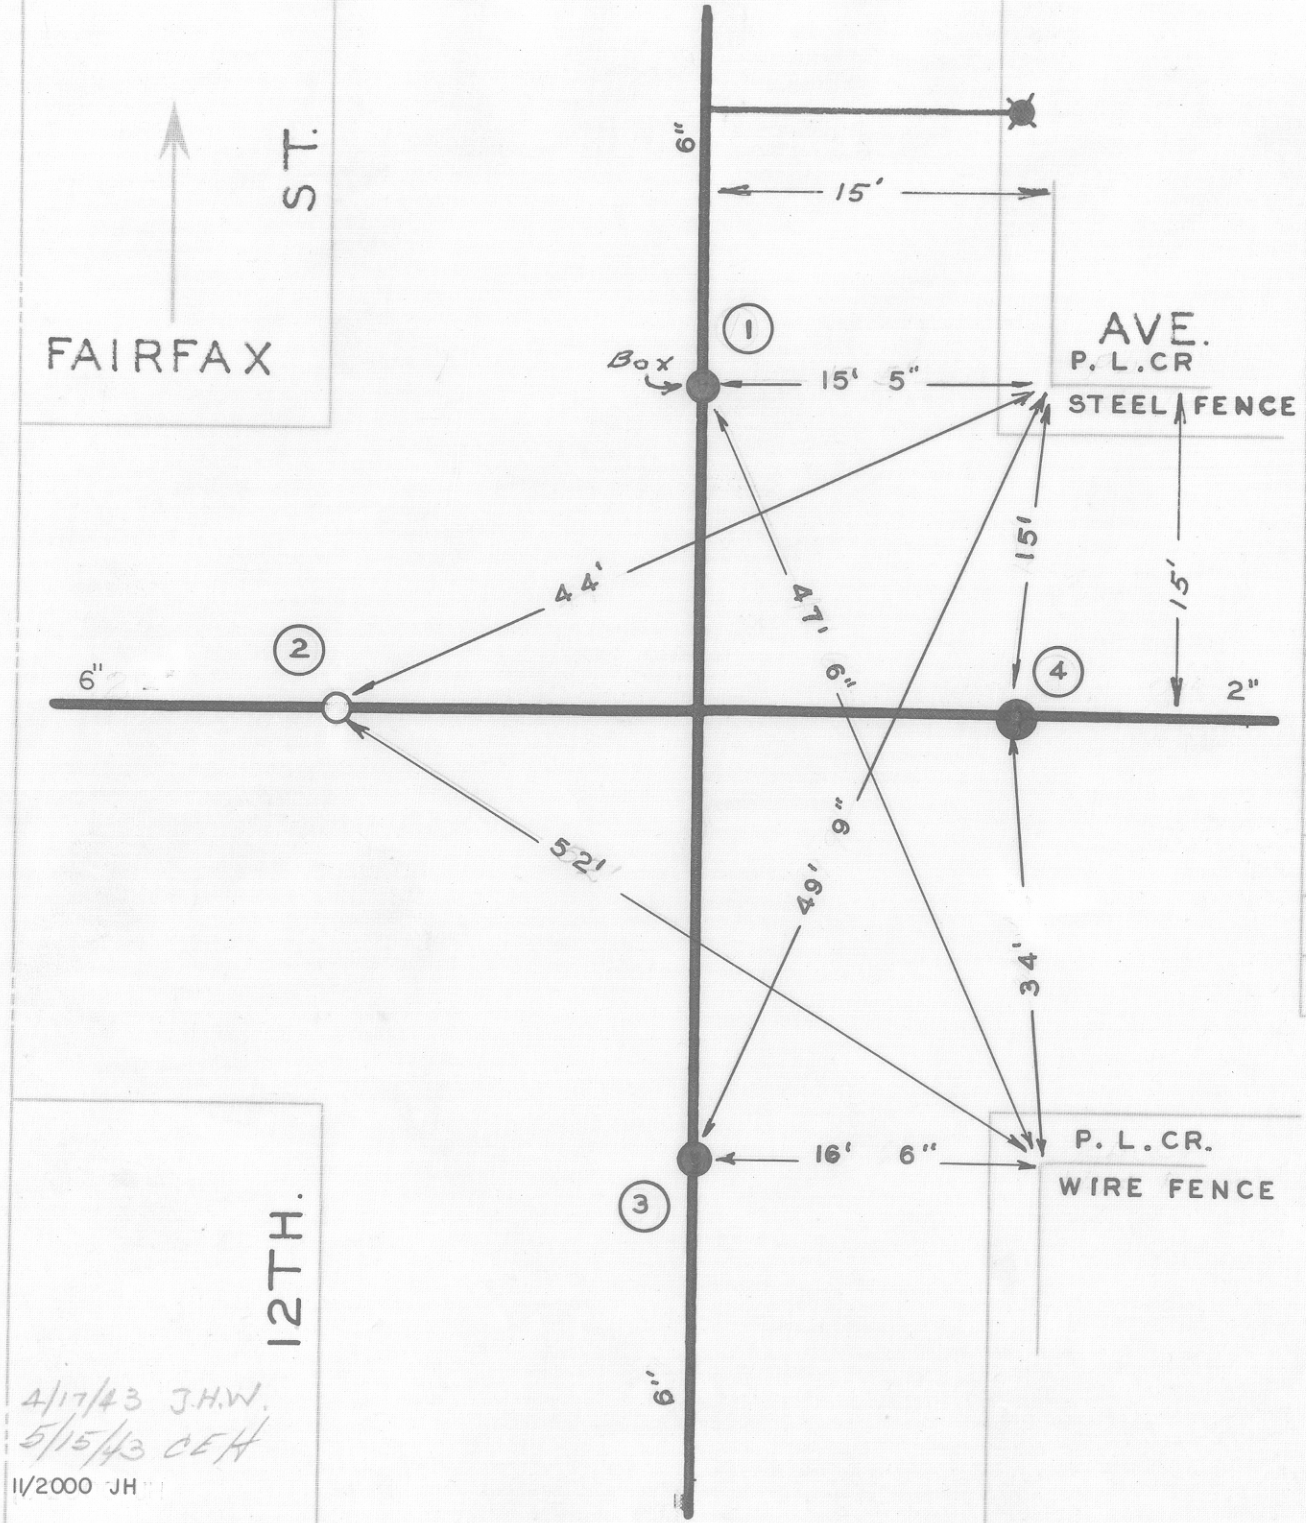

DATE	NO.	SIZE	MAKE	OPEN	TURNS
1891	1	6"		R	20
1903	2	6"		R	20 1/2
1891	3	6"		R	20 1/2
1903	4	2"		R	7
	1	6'-S	NPL		
	2	9'-E	WPL		
	3	0	SPL		
	4	2'-W	EPL		

4/17/43 J.H.W.
5/15/43 CEH
11/2000 JH

CITY OF ROANOKE—WATER DEP'T

VALVE DIAGRAM

FAIRFAX AVE. &
12 TH. STREET

SEC. MAP 221, 222 N.W.

DATE PAGE NO. N.W. 132