DATE	NO	SIZE	MAKE	OPEN	TURNS
2-72	1	6"	MUELLER	R	
2-72	2	6"	MUELLER	R	

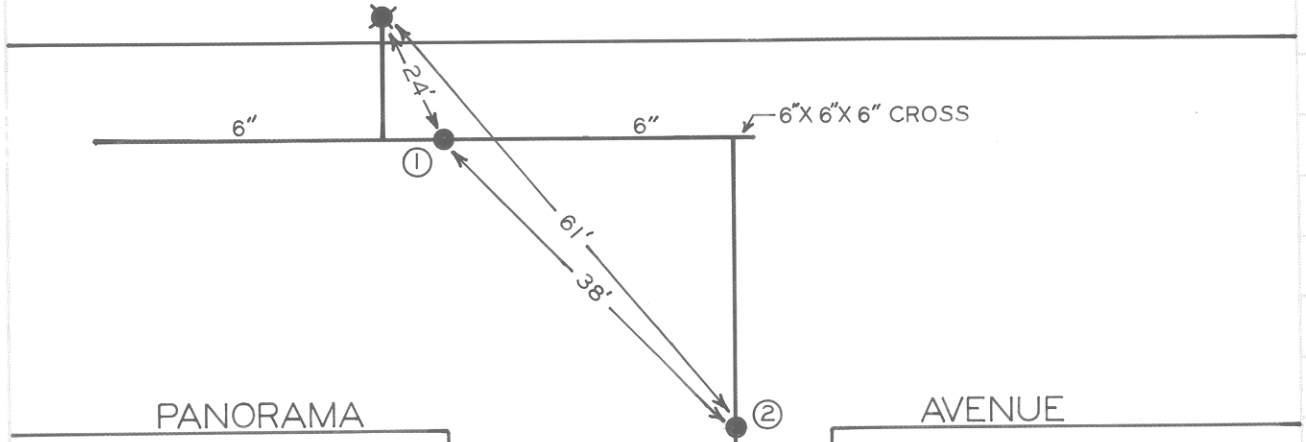

PANORAMA AVENUE

FAIRVIEW ROAD

6"

CITY OF ROANOKE — WATER DEP'T

VALVE DIAGRAM

FAIRVIEW ROAD &

PANORAMA AVENUE N.W.

SEC. MAP 274

DATE PAGE NO.