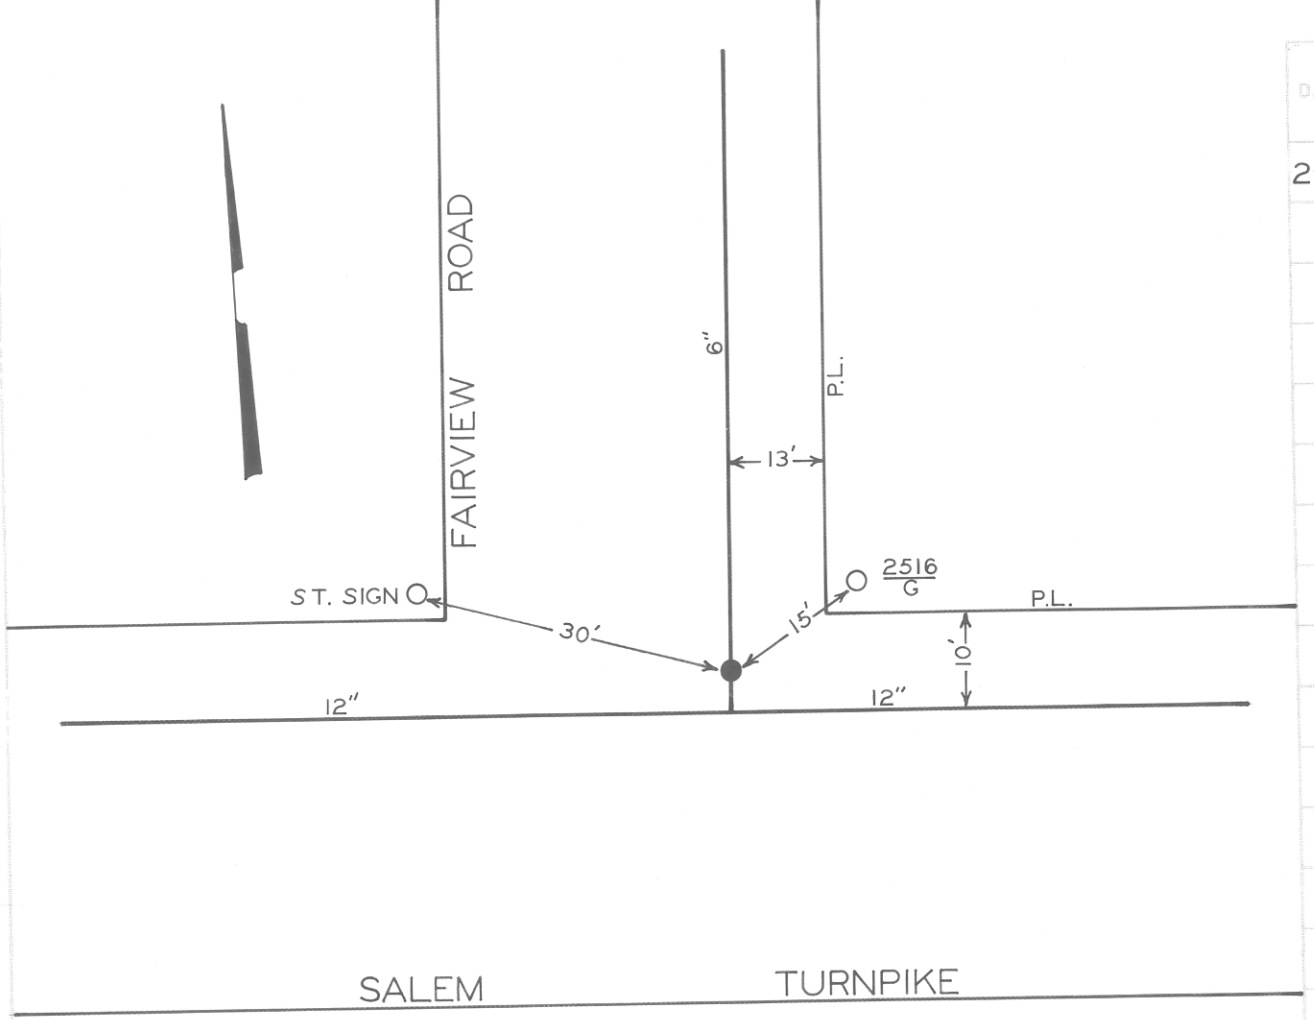

DATE	NO.	SIZE	MAKE	OPEN	TURNS
2-72	1	6"	DARLING	R	

CITY OF ROANOKE — WATER DEP'T

VALVE DIAGRAM

FAIRVIEW ROAD &

SALEM TURNPIKE N.W.

SEC. MAP 274

DATE PAGE NO.