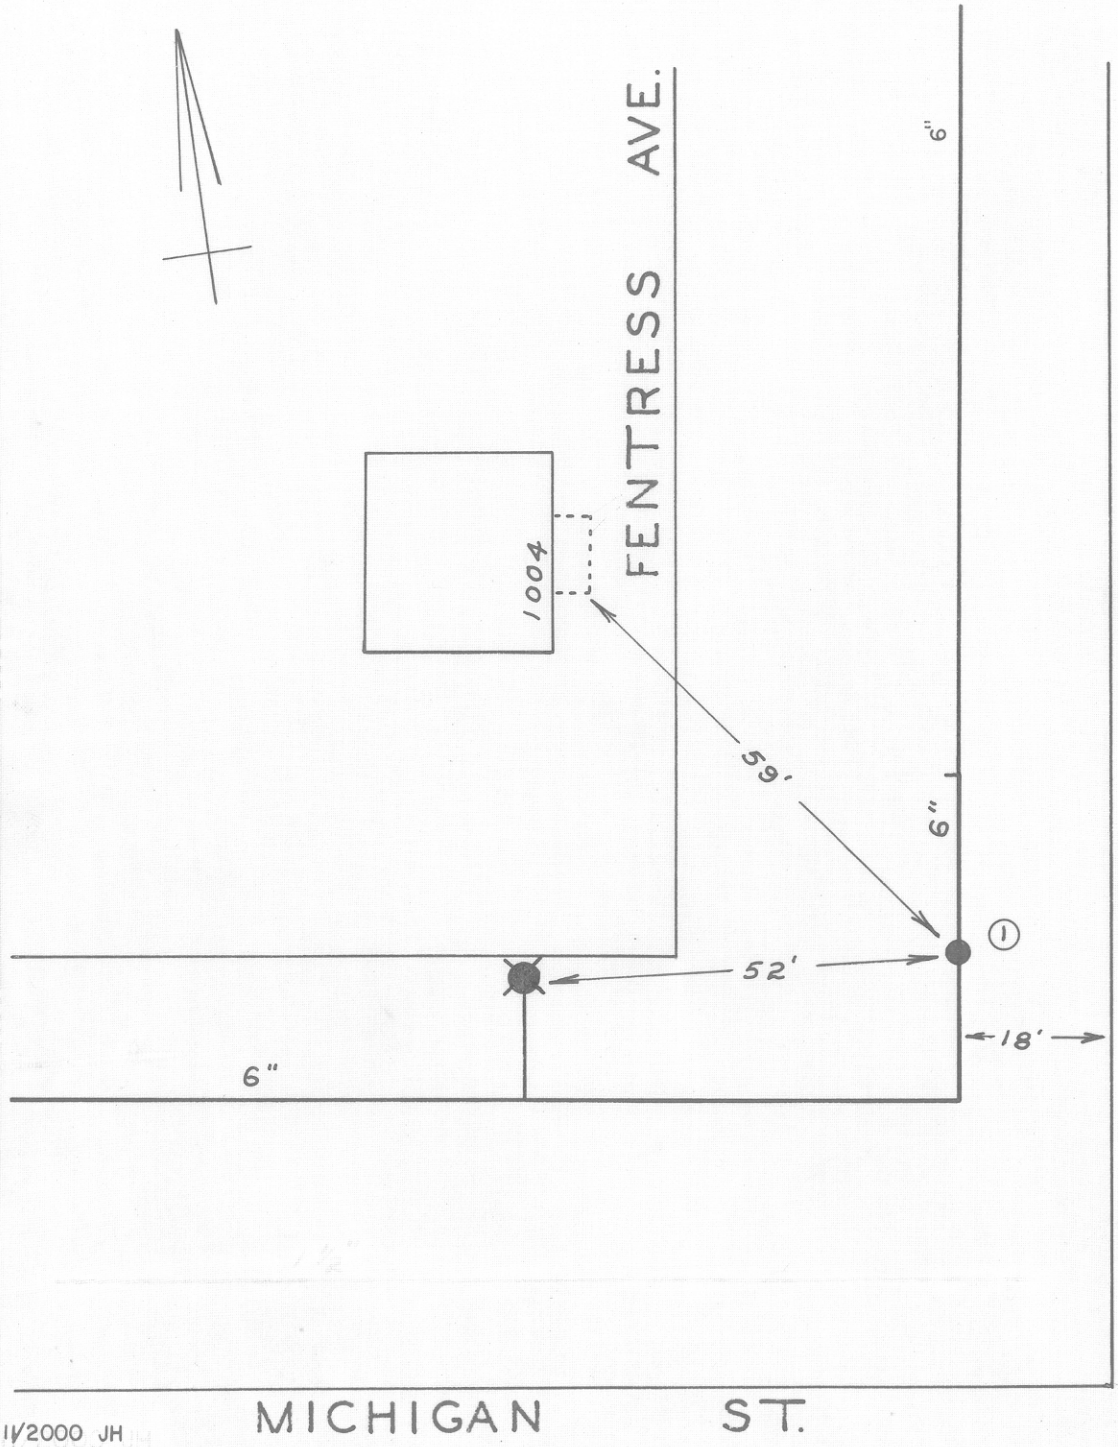

1½2000 JH

DATE	NO.	SIZE	MAKE	OPEN	TURNS
1953	1	6"	MUELLER	R	20
	1	0	NPL		

CITY OF ROANOKE — WATER DEPT.

VALVE DIAGRAM

FENTRESS AVE. &

MICHIGAN ST.

SEC. MAP 275 N.W.

DATE PAGE NO.

"IMPERIAL" TRACING CLOTH
K & E CO., N. Y.