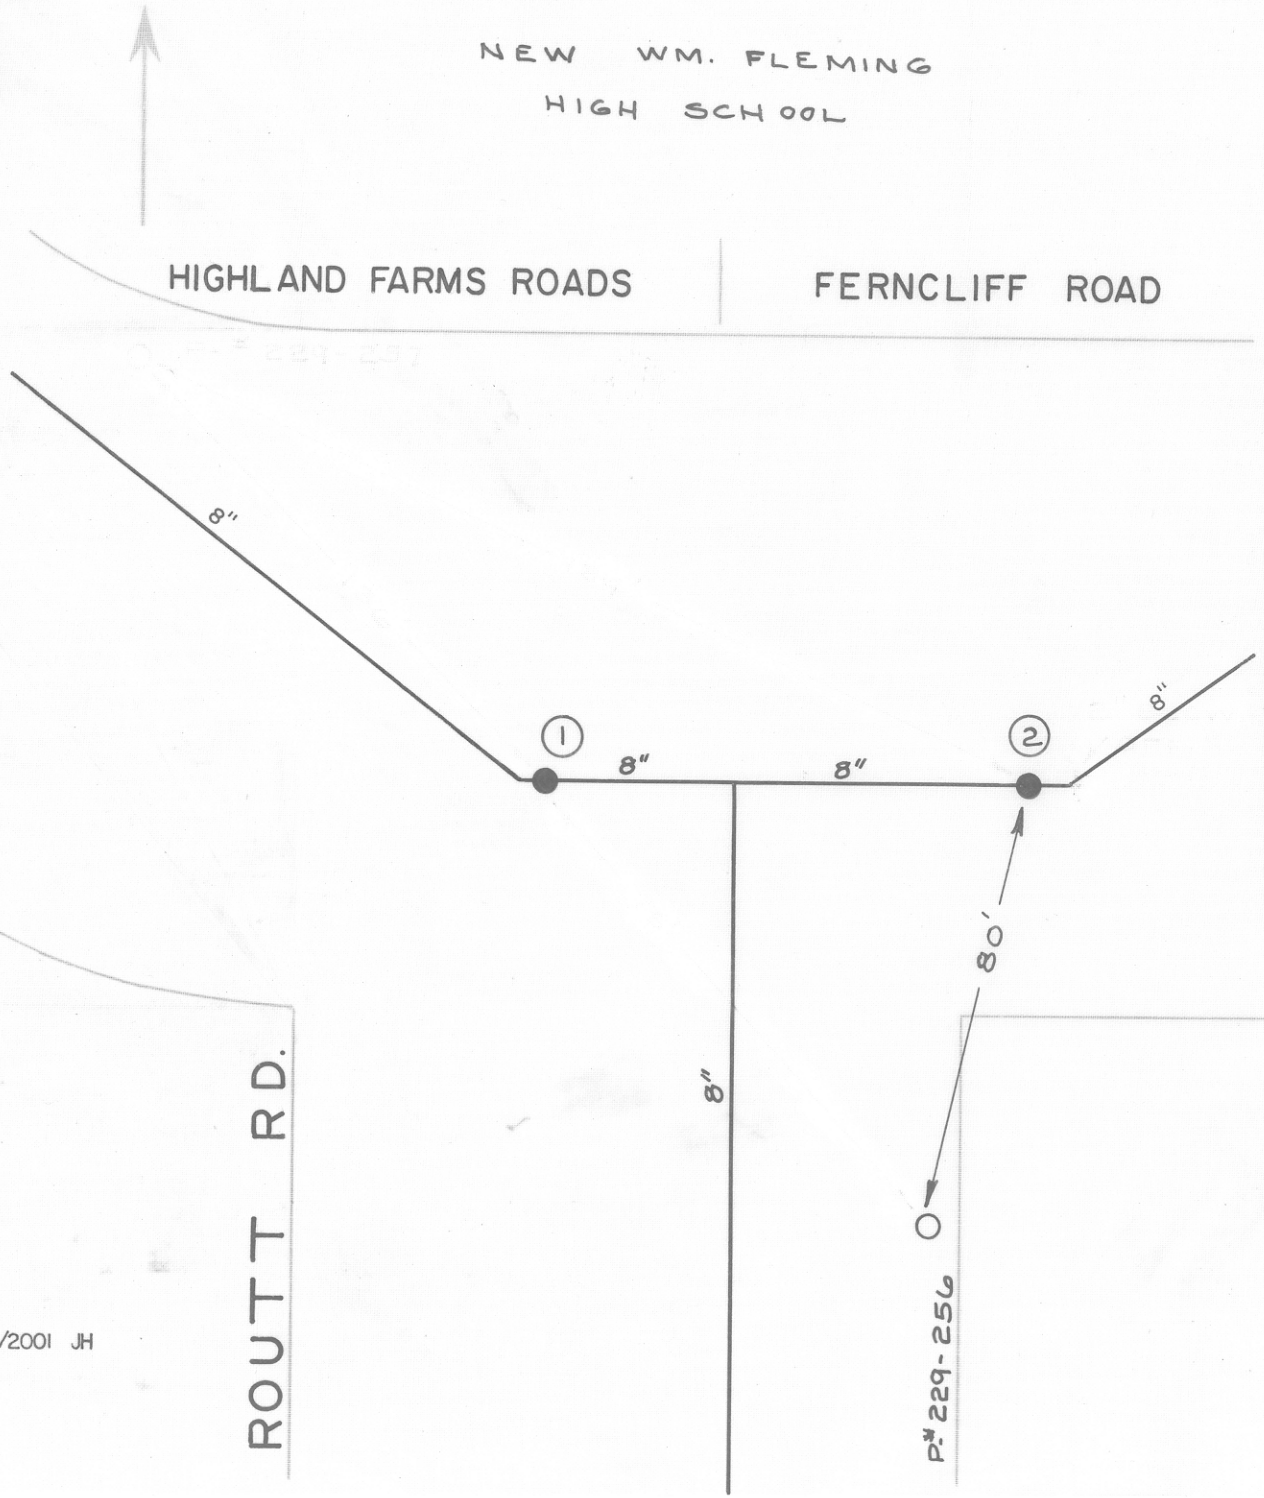

DATE	NO.	SIZE	MAKE	OPEN	TURNS
10-60	1	8"	DAR.	R	
10-60	2	8"	DAR.	R	

CITY OF ROANOKE—WATER DEP'T

VALVE DIAGRAM

FERNCLIFF ROAD &

HIGHLAND FARMS ROADS &

ROUTT ROAD

SEC. MAP 644, 646 N.W.

DATE PAGE NO.