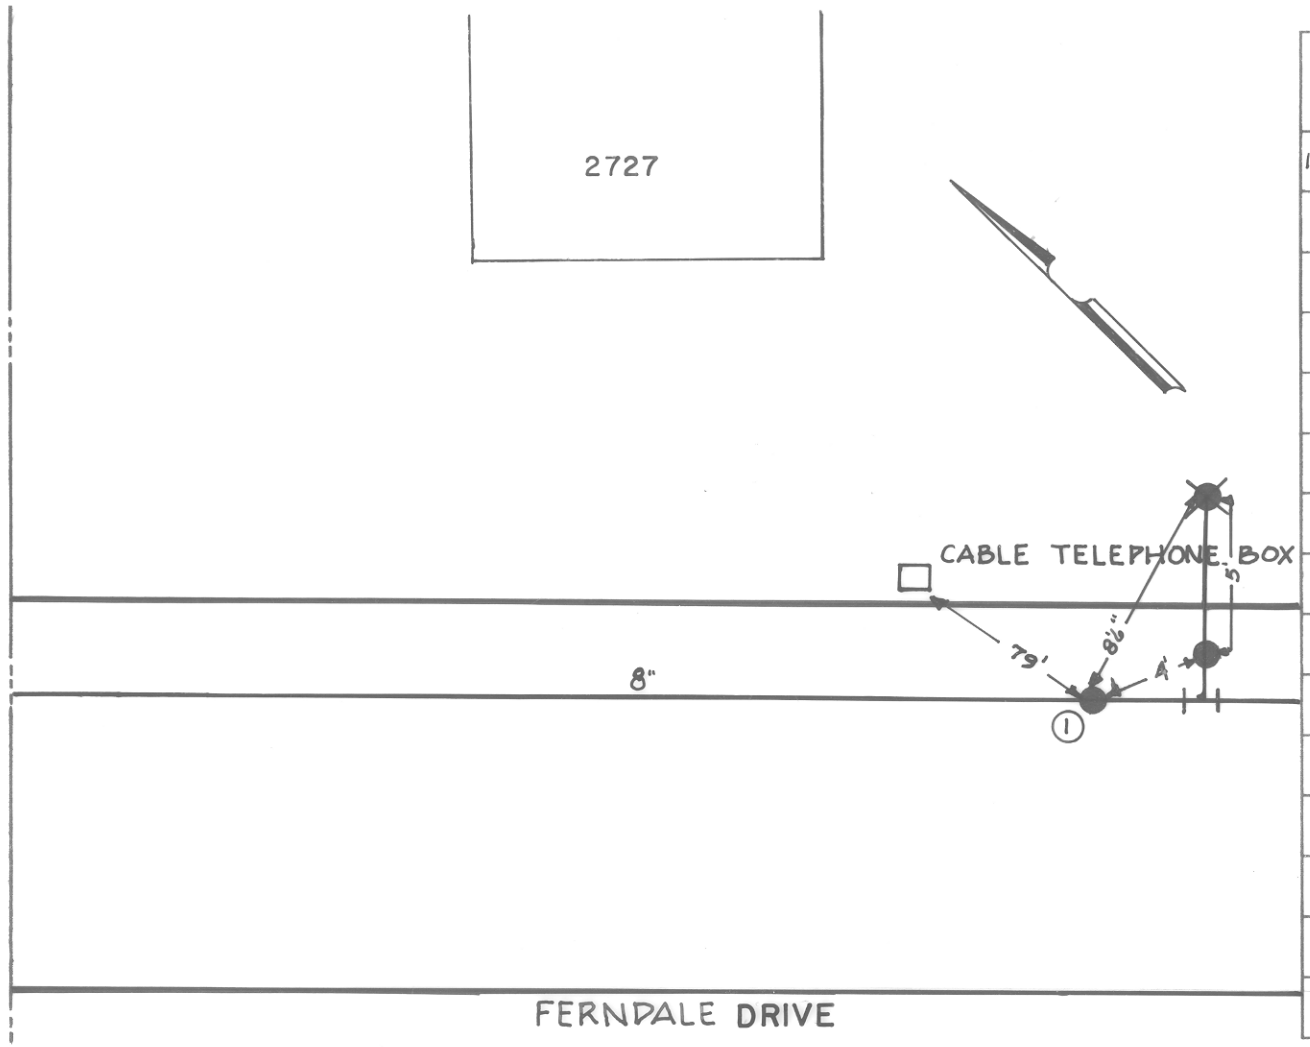


| DATE | NO. | SIZE | MAKE | OPEN | TURNS |
|---|---|---|---|---|---|
| 11-80 | 1 | 8" | MUELLER | R | |
| | | | | | |
| | | | | | |
3/2001 JH

CITY OF ROANOKE—WATER DEP'T

VALVE DIAGRAM

FERNDALE DRIVE

N.W.

SEC. MAP 646

DATE NOV. 28, 1980 PAGE NO.