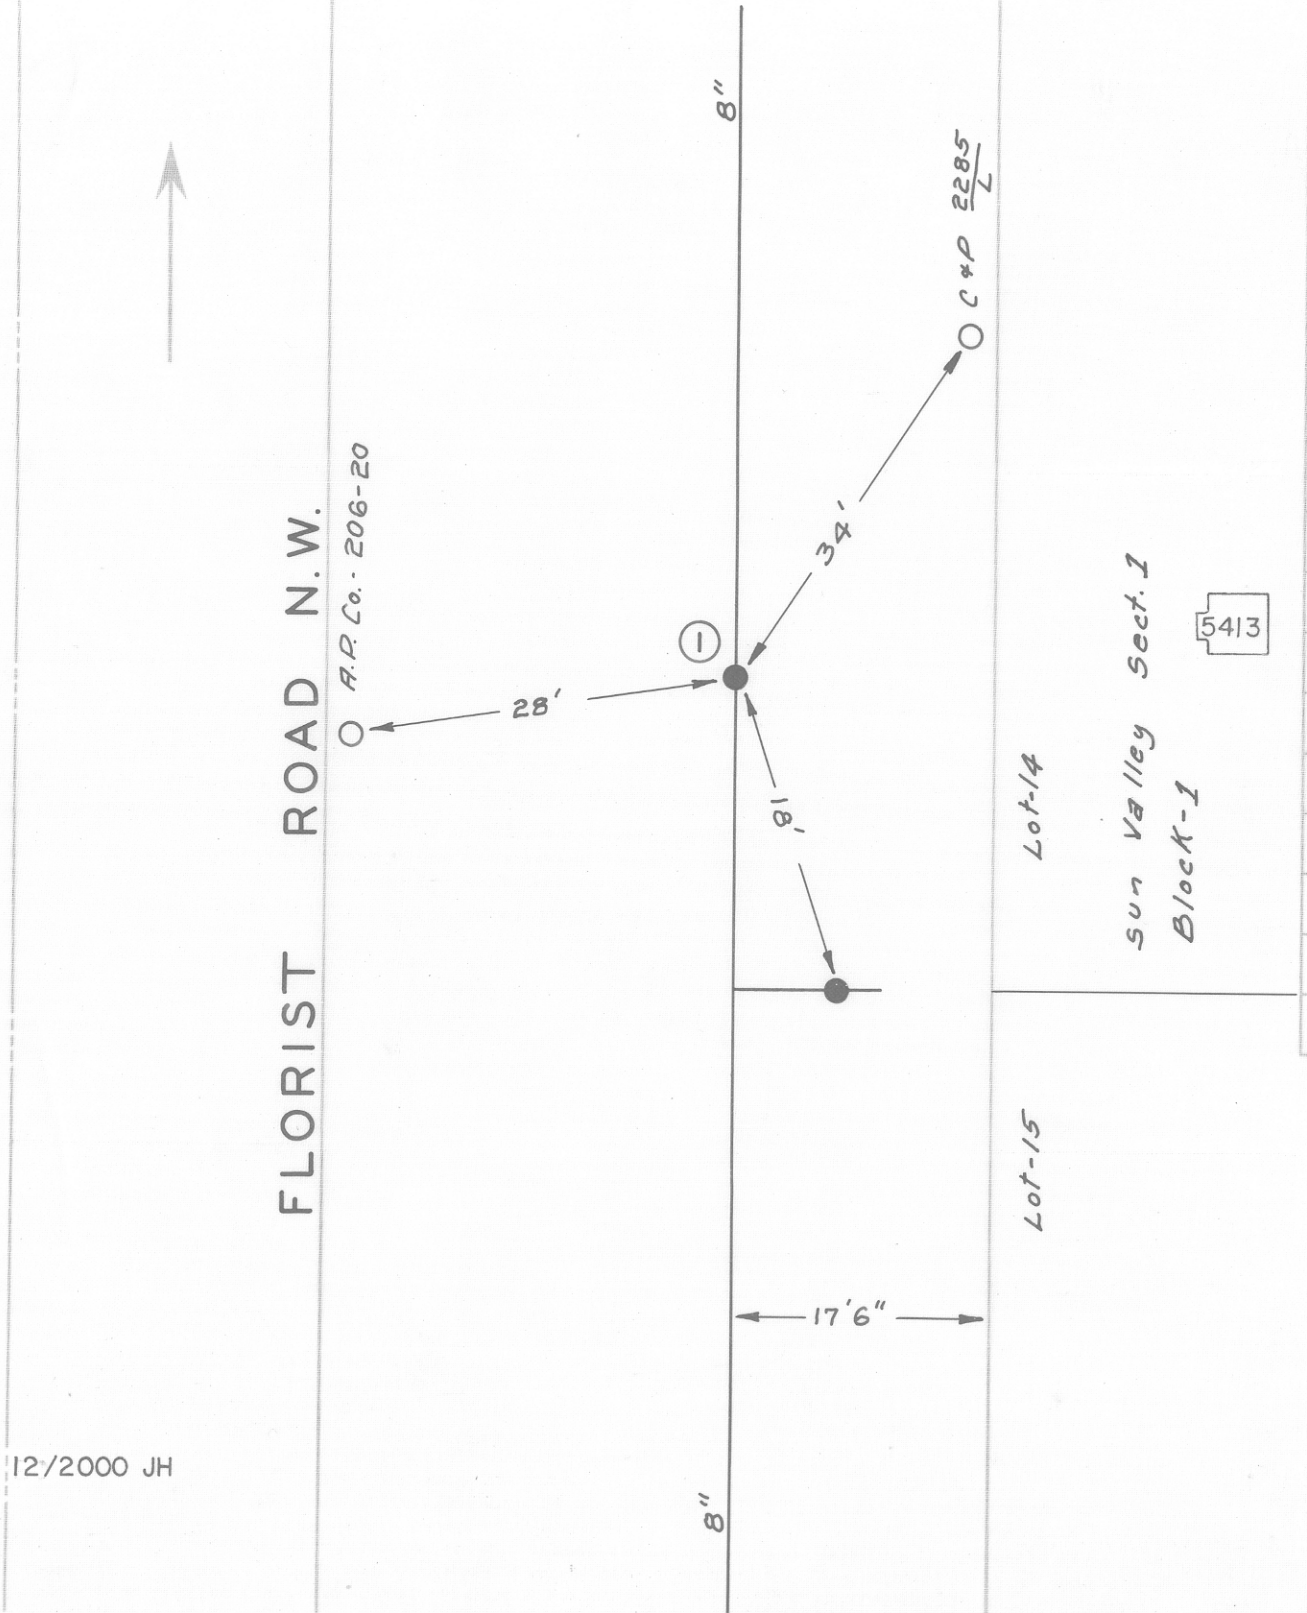

DATE	NO.	SIZE	MAKE	OPEN	TURNS
'59	1	8"	DARLING	R	

CITY OF ROANOKE—WATER DEP'T

VALVE DIAGRAM

FLORIST RD. N.W. APPROX.

1000 N. OF BONHILL

AVE. N.W.

SEC. MAP 220 N.W. R.O. 30 Ro.Co.

DATE PAGE NO.

12/2000 JH