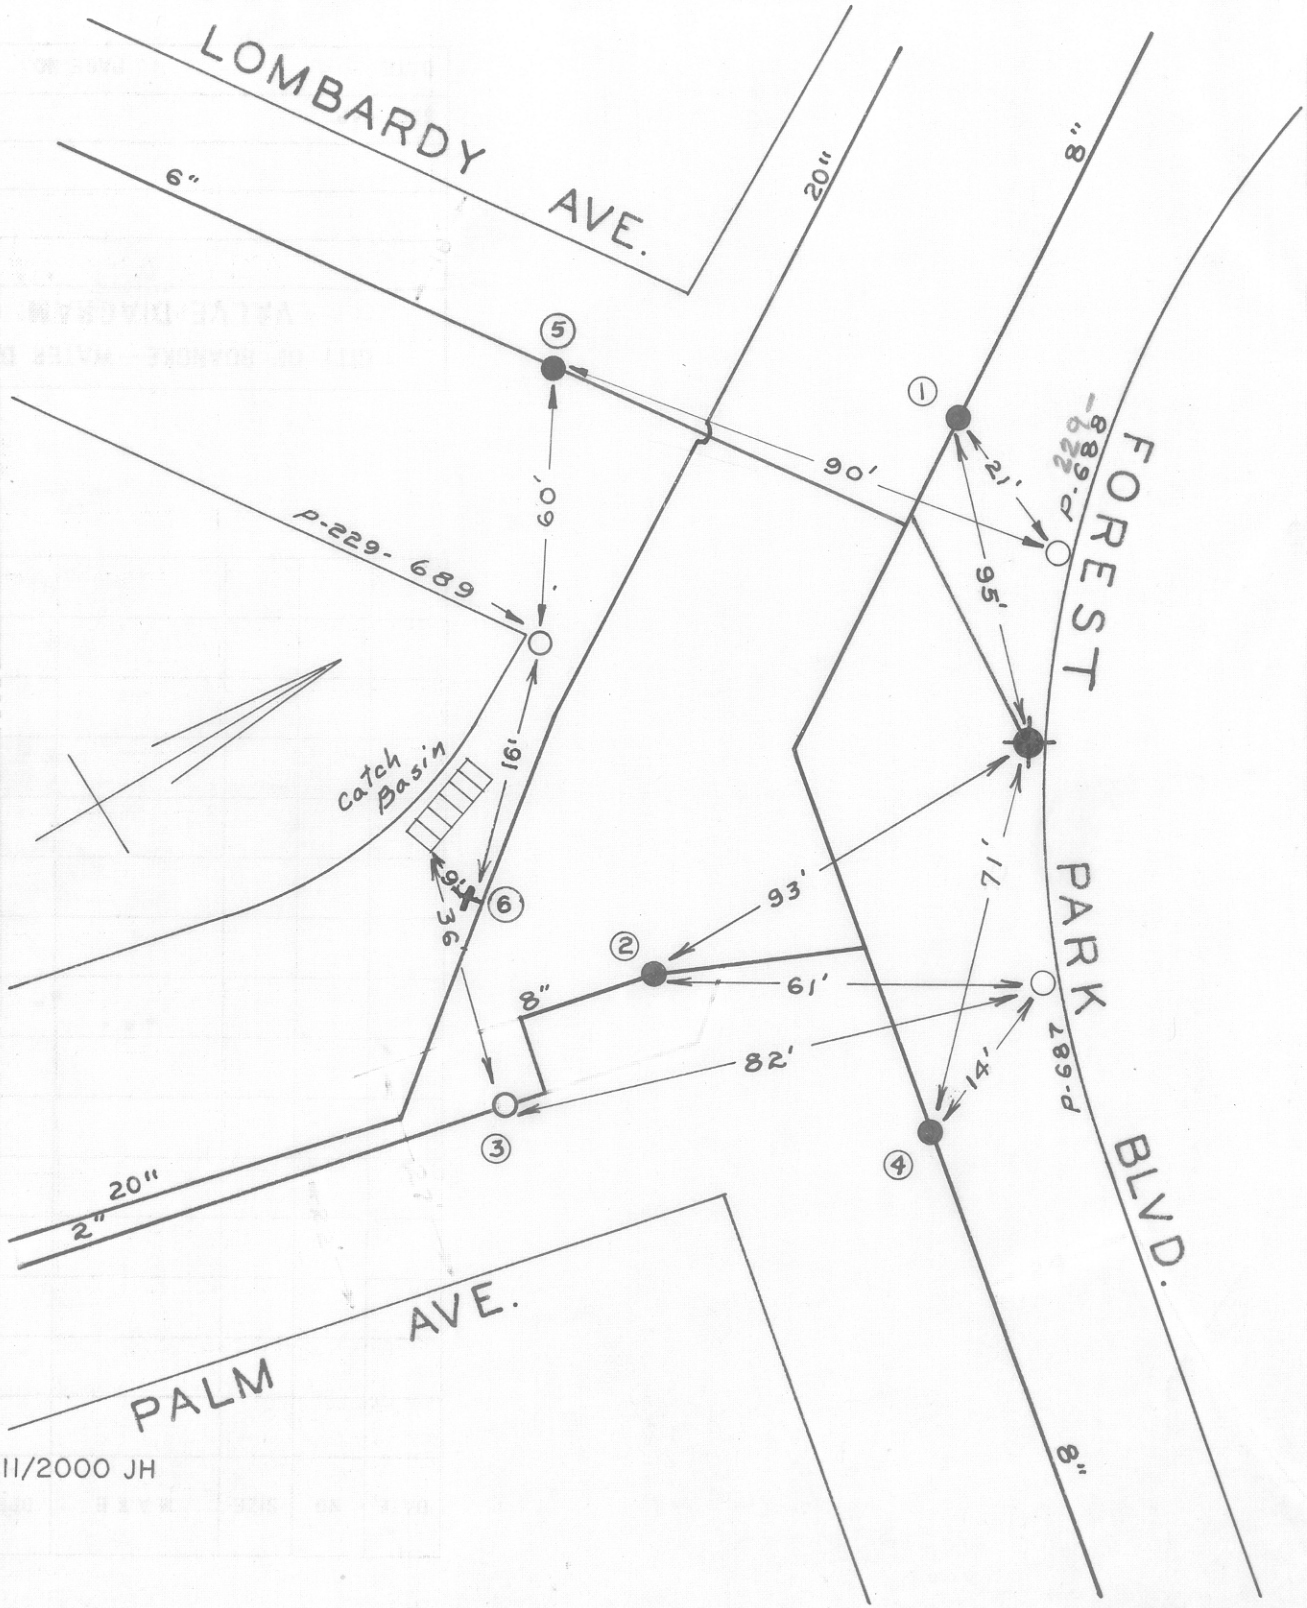

DATE	NO.	SIZE	MAKE	OPEN	TURNS
1947	1	8"	DARLING	R	27
1950	2	8"	DARLING	R	27
1950	3	2"			
1958	4	8"	DARLING	R	27
1939	5	6"	MUELLER	R	
12-64	6	6"	DARLING ↑ BLOW-OFF	R	21
	1	0	NPL		
	2	0	SPL		
	3	24'-S	SPL		
	4	0	EPL		
	5	15'-W	WPL		

11/2000 JH

"IMPERIAL" TRACING CLOTH. K & E CO., N.Y.

CITY OF ROANOKE — WATER DEPT.

VALVE DIAGRAM

FOREST PARK BLVD. - LOMBARDY AVE. & PALM AVE.

SEC. MAP 244, 243 N. W.

DATE PAGE NO.