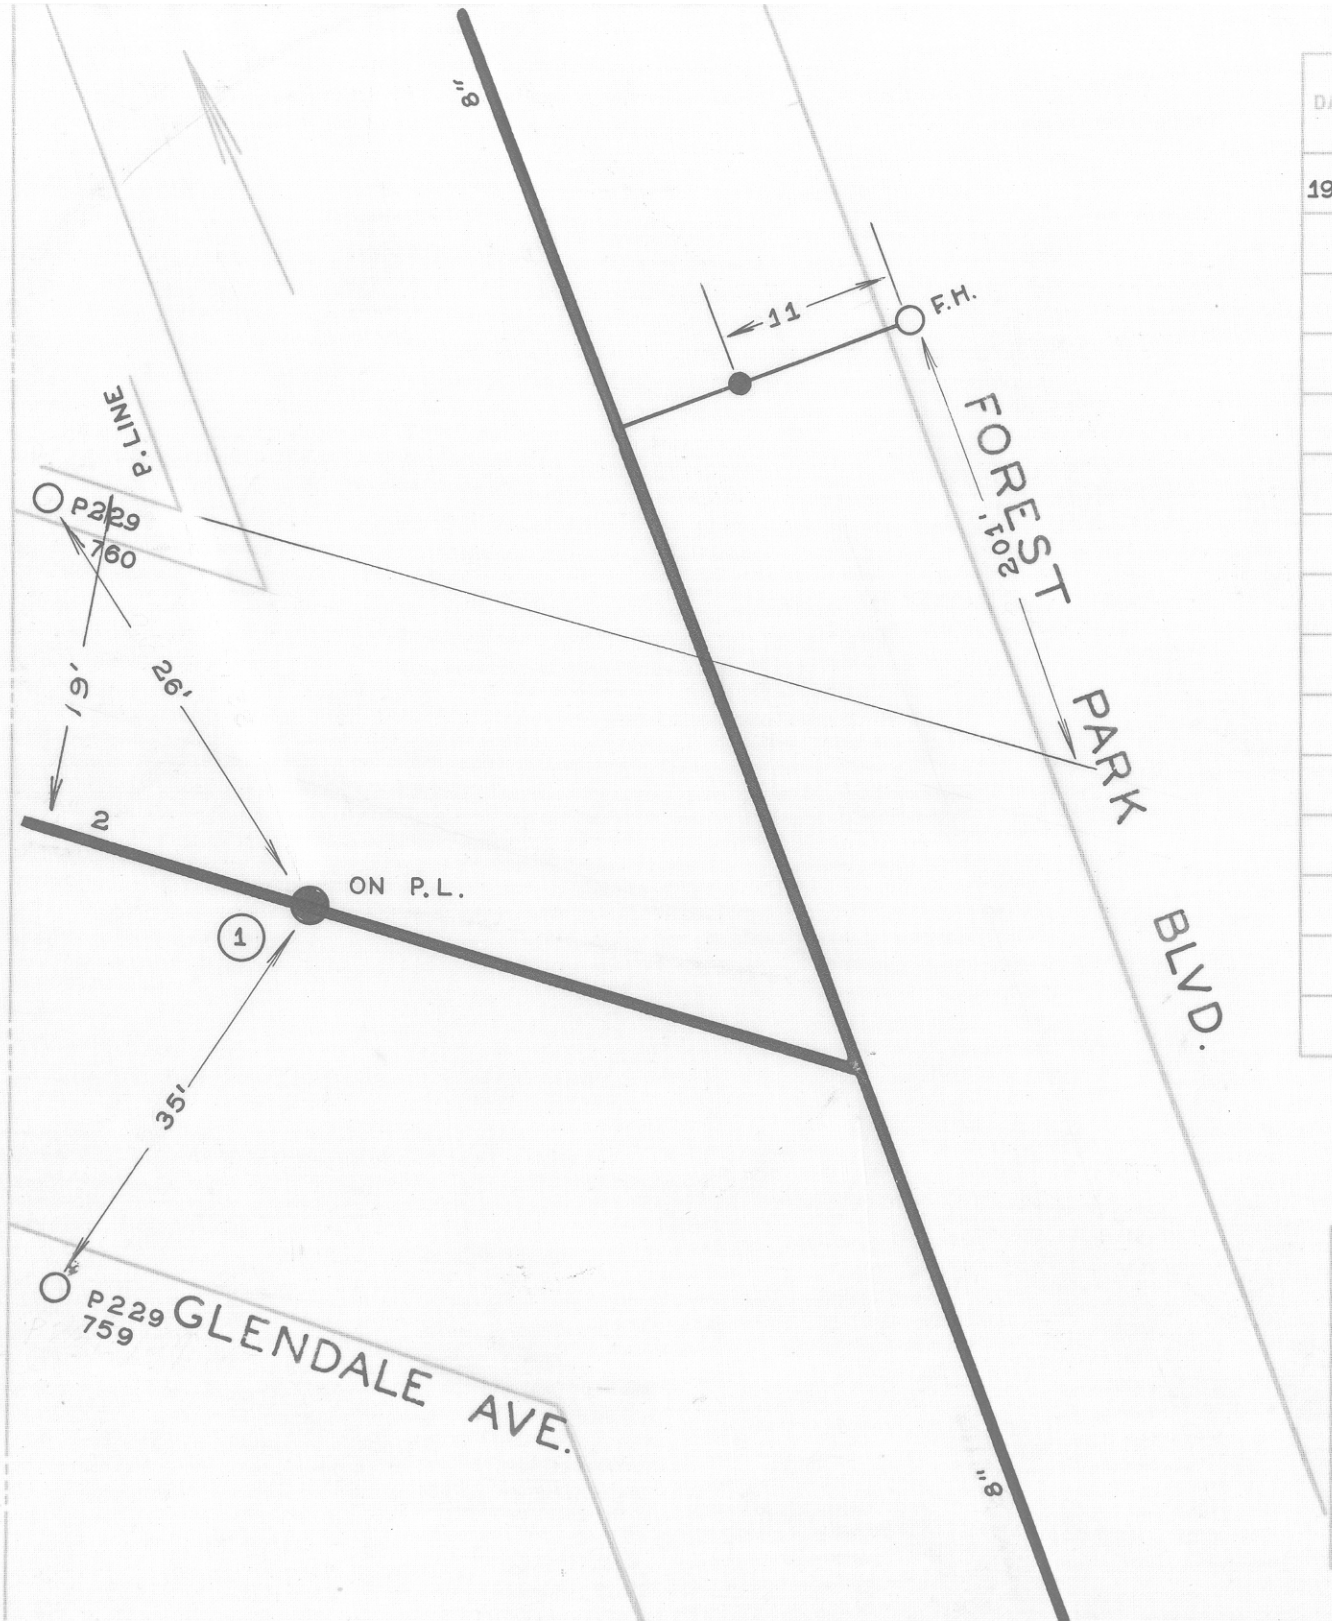

DATE	NO.	SIZE	MAKE	OPEN	TURNS
1949	1	2"	DARLING	R	7
	1	0	WPL		

CITY OF ROANOKE — WATER DEP'T

VALVE DIAGRAM

FOREST PARK BOULEVARD

GLENDALE AVENUE N.W.

SEC. MAP 244

DATE

PAGE NO. NW342