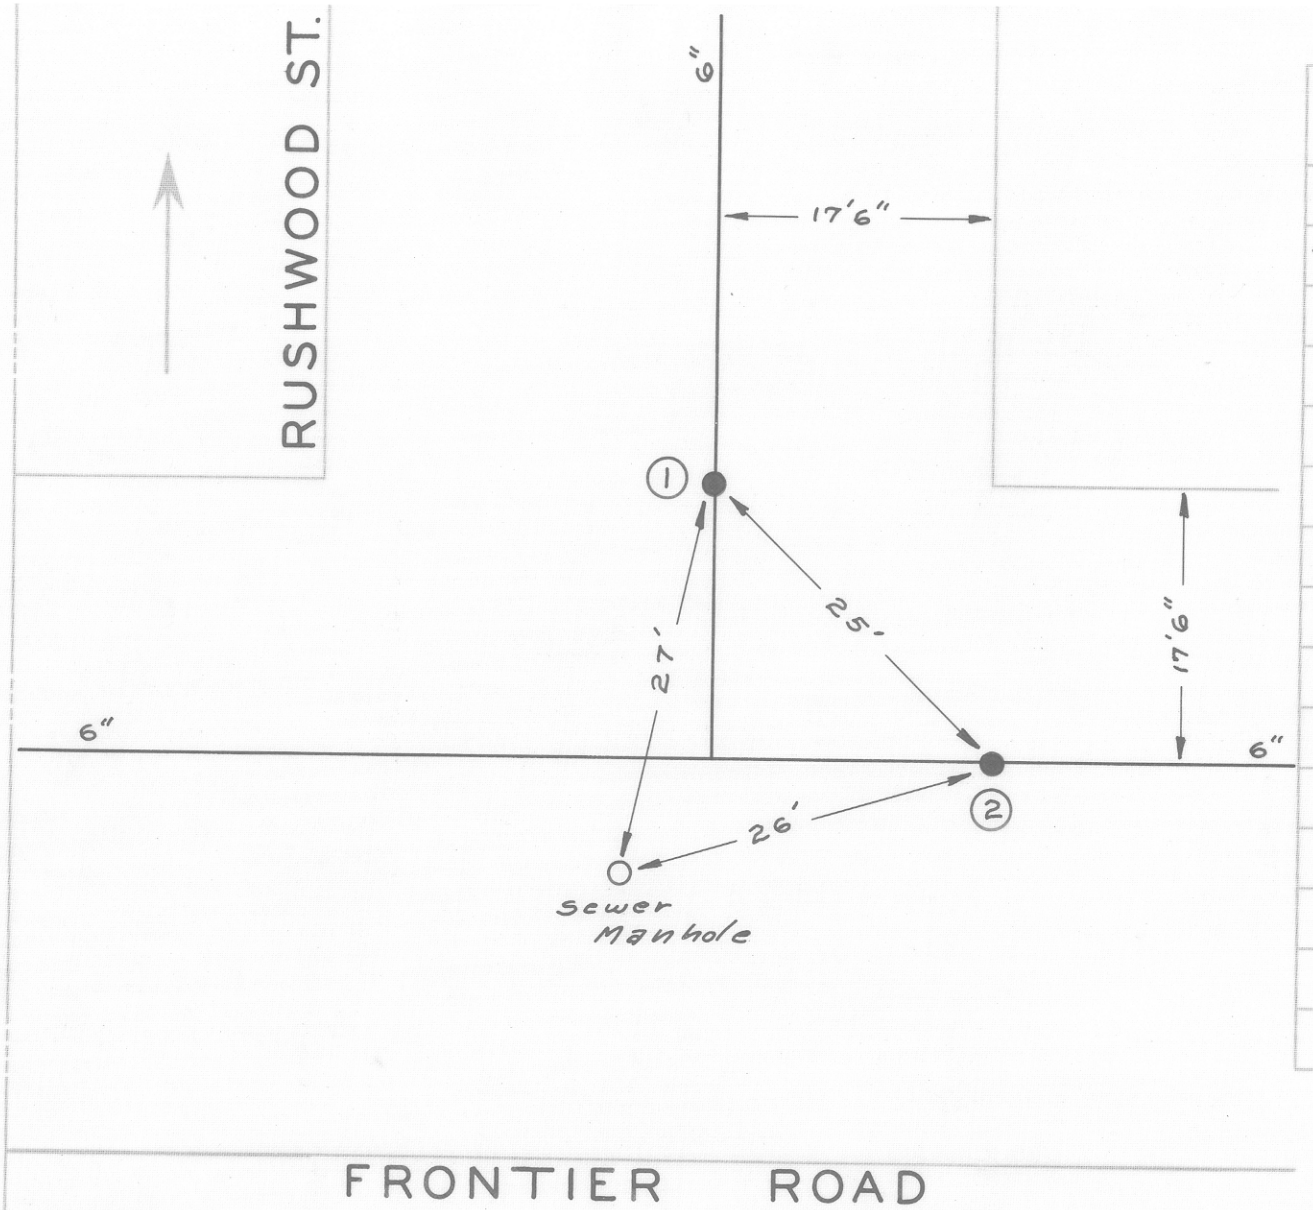

DATE	NO.	SIZE	MAKE	OPEN	TURNS
'59	1	6"	MUELLER	R	20
'59	2	6"	MUELLER	R	20
	1	0	NPL		
	2	0	EPL		

CITY OF ROANOKE—WATER DEP'T

VALVE DIAGRAM

FRONTIER RD. &

RUSHWOOD ST. N.W.

SEC. MAP 210 218 N.W.

DATE PAGE NO.

11/2000 JH