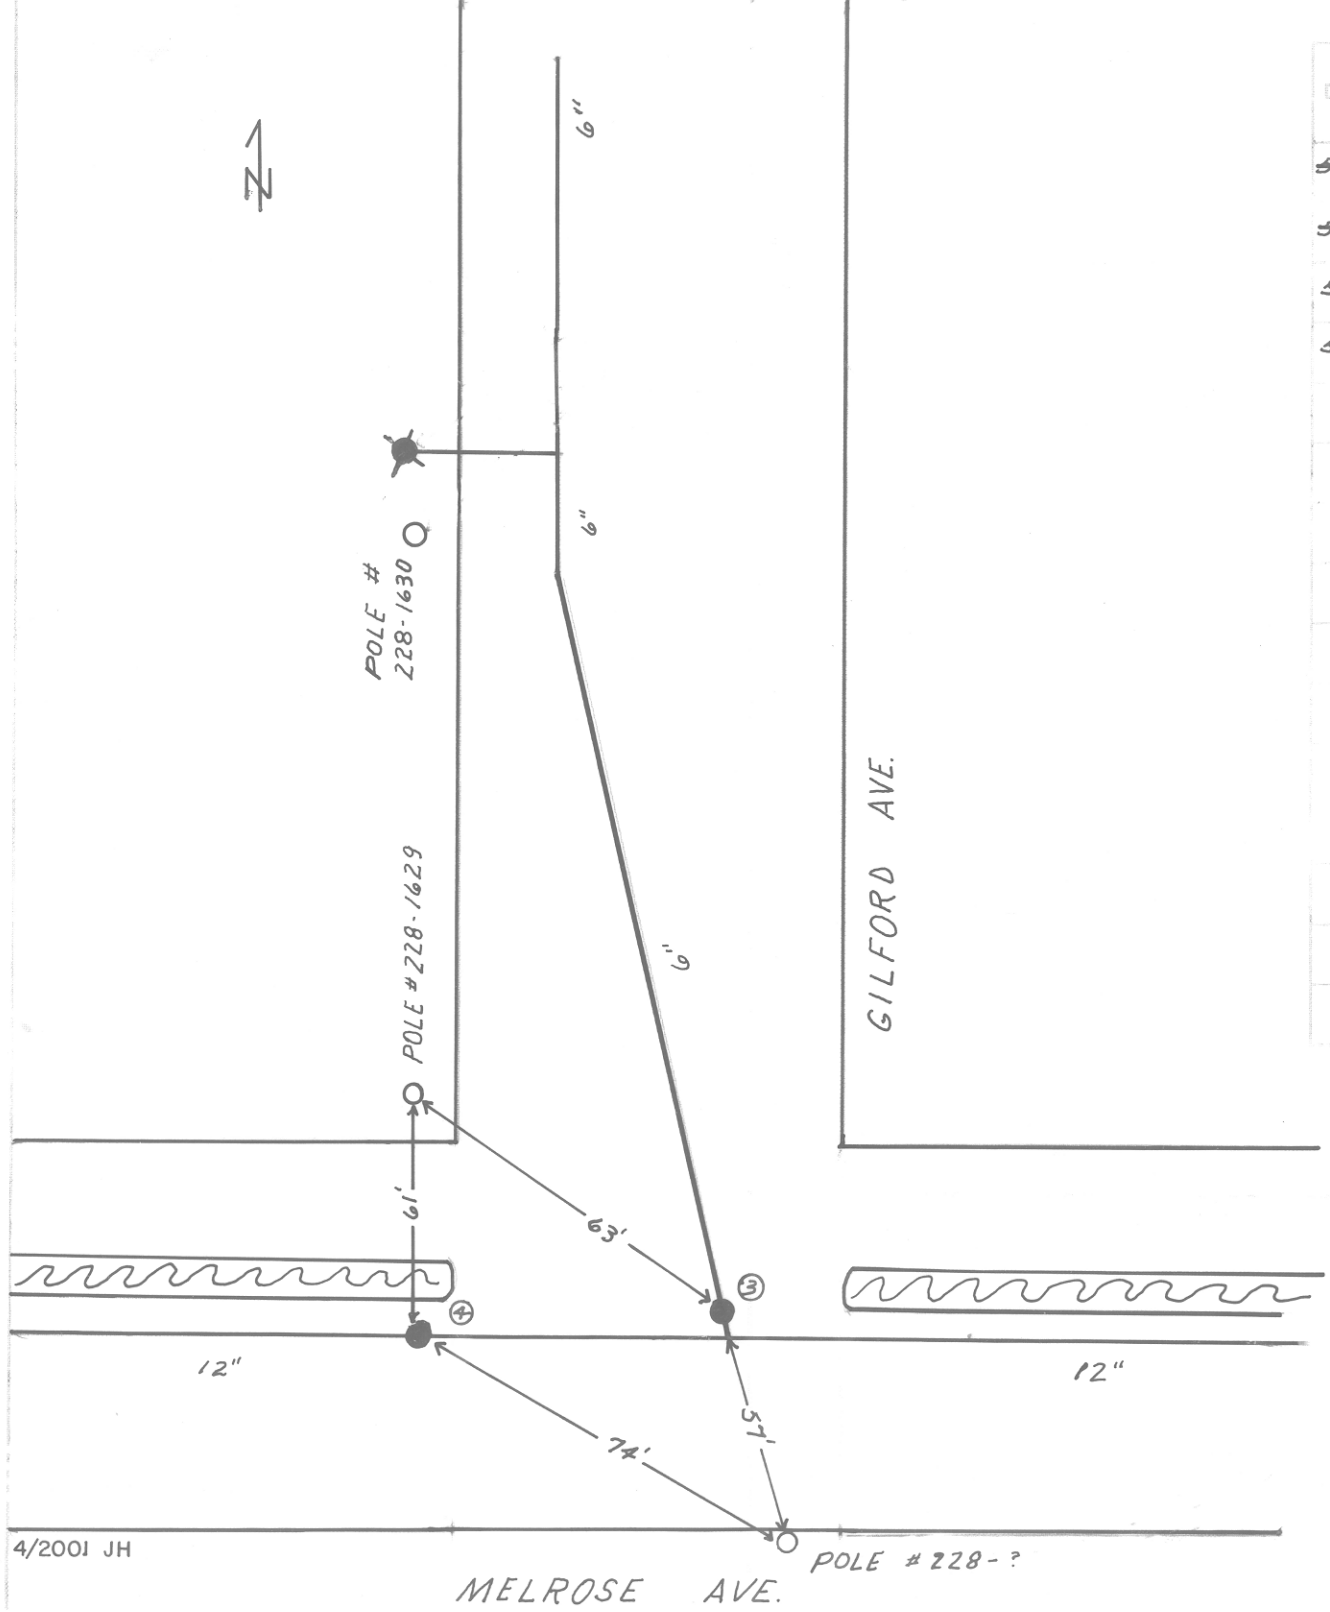

DATE	NO	SIZE	MAKE	OPEN	TURNS
~~5-80~~	~~1~~	~~6"~~	~~MUELLER~~	~~R~~	
~~5-80~~	~~2~~	~~2"~~	~~MISC.~~	~~L~~	
5-80	3	6"	MUELLER	R	
5-80	4	12"	MUELLER	R	

CITY OF ROANOKE WATER DEP'T
VALVE DIAGRAM

GILFORD AVE. – 150' N. OF MELROSE &
MELROSE AVE.

SEC. MAP 611 N.W.

DATE PAGE NO.