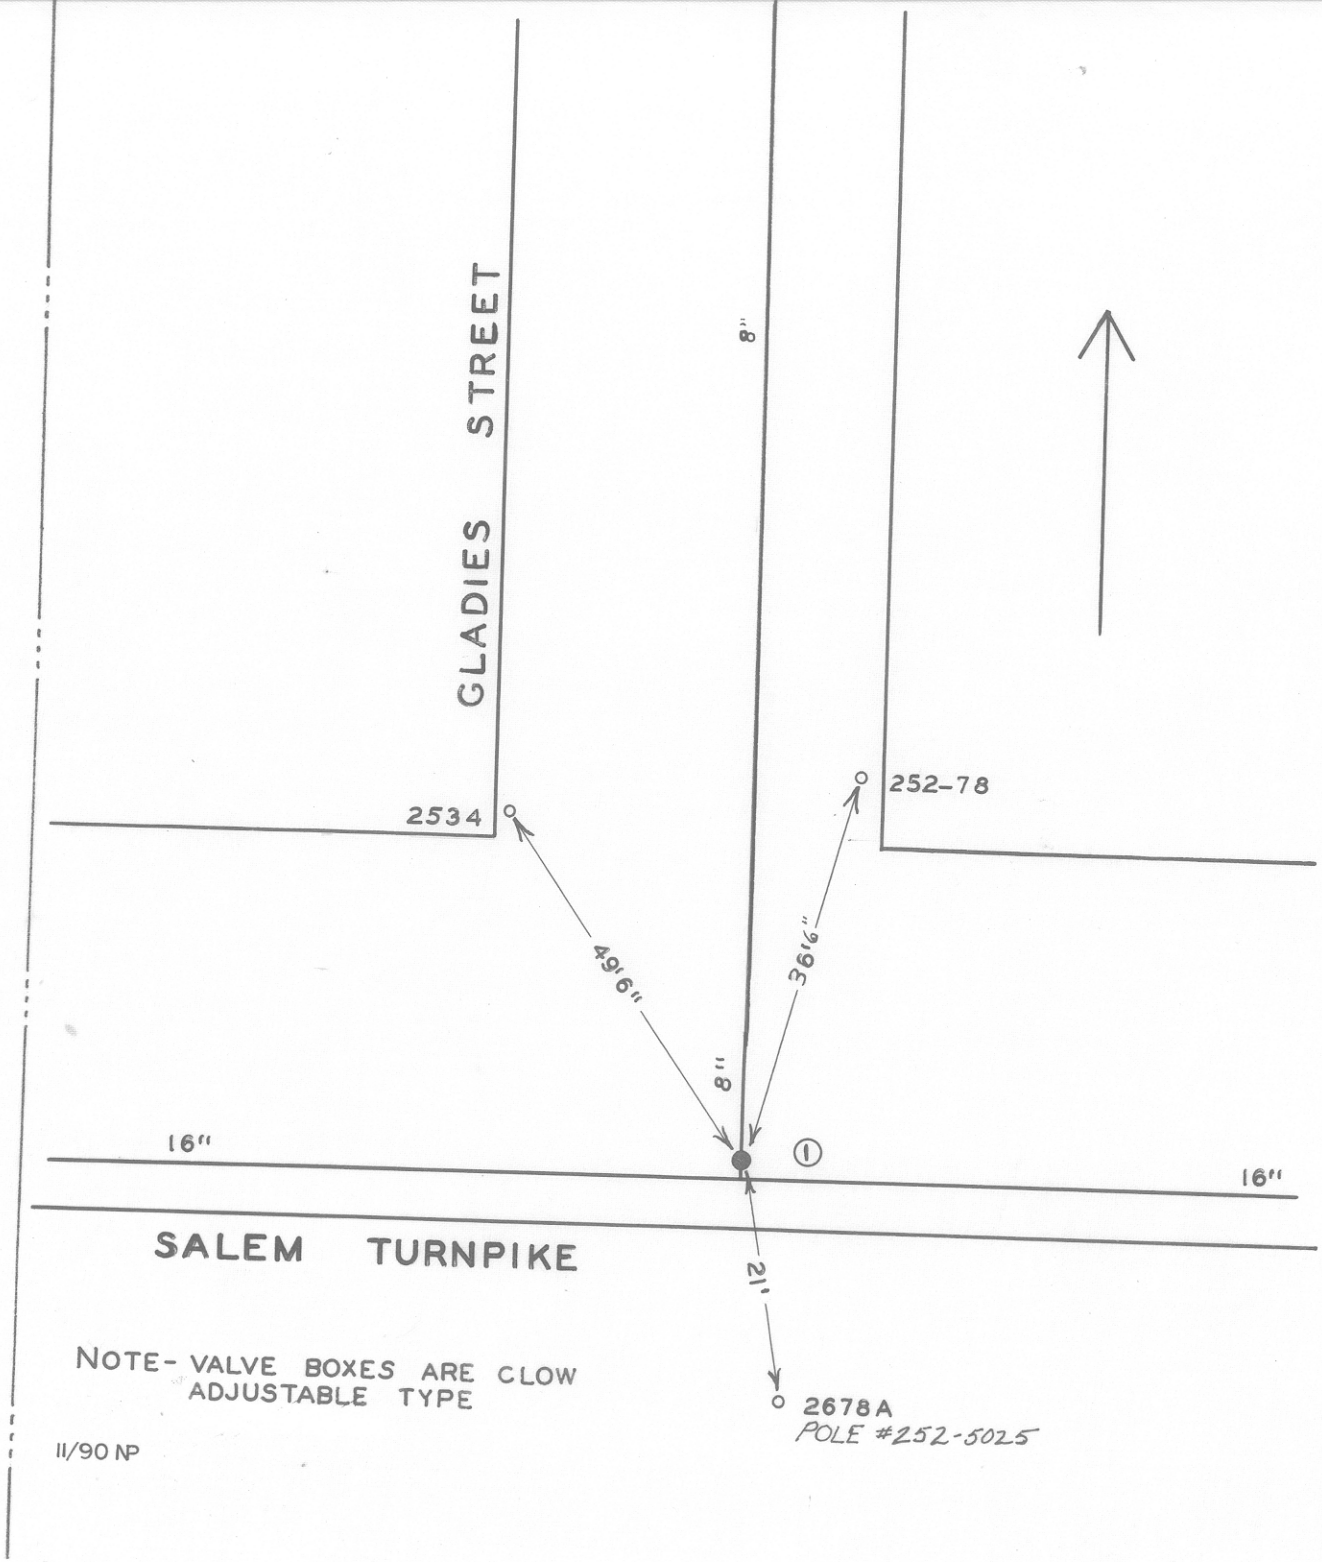

NOTE- VALVE BOXES ARE CLOW ADJUSTABLE TYPE

11/90 NP

DATE	NO.	SIZE	MAKE	OPEN	TURNS
4-63	1	8"	DARLING	R	26 1/2

CITY OF ROANOKE – WATER DEPT.
VALVE DIAGRAM
GLADIES STREET &
SALEM TURNPIKE N.W.
SEC. MAP 605
DATE PAGE NO.