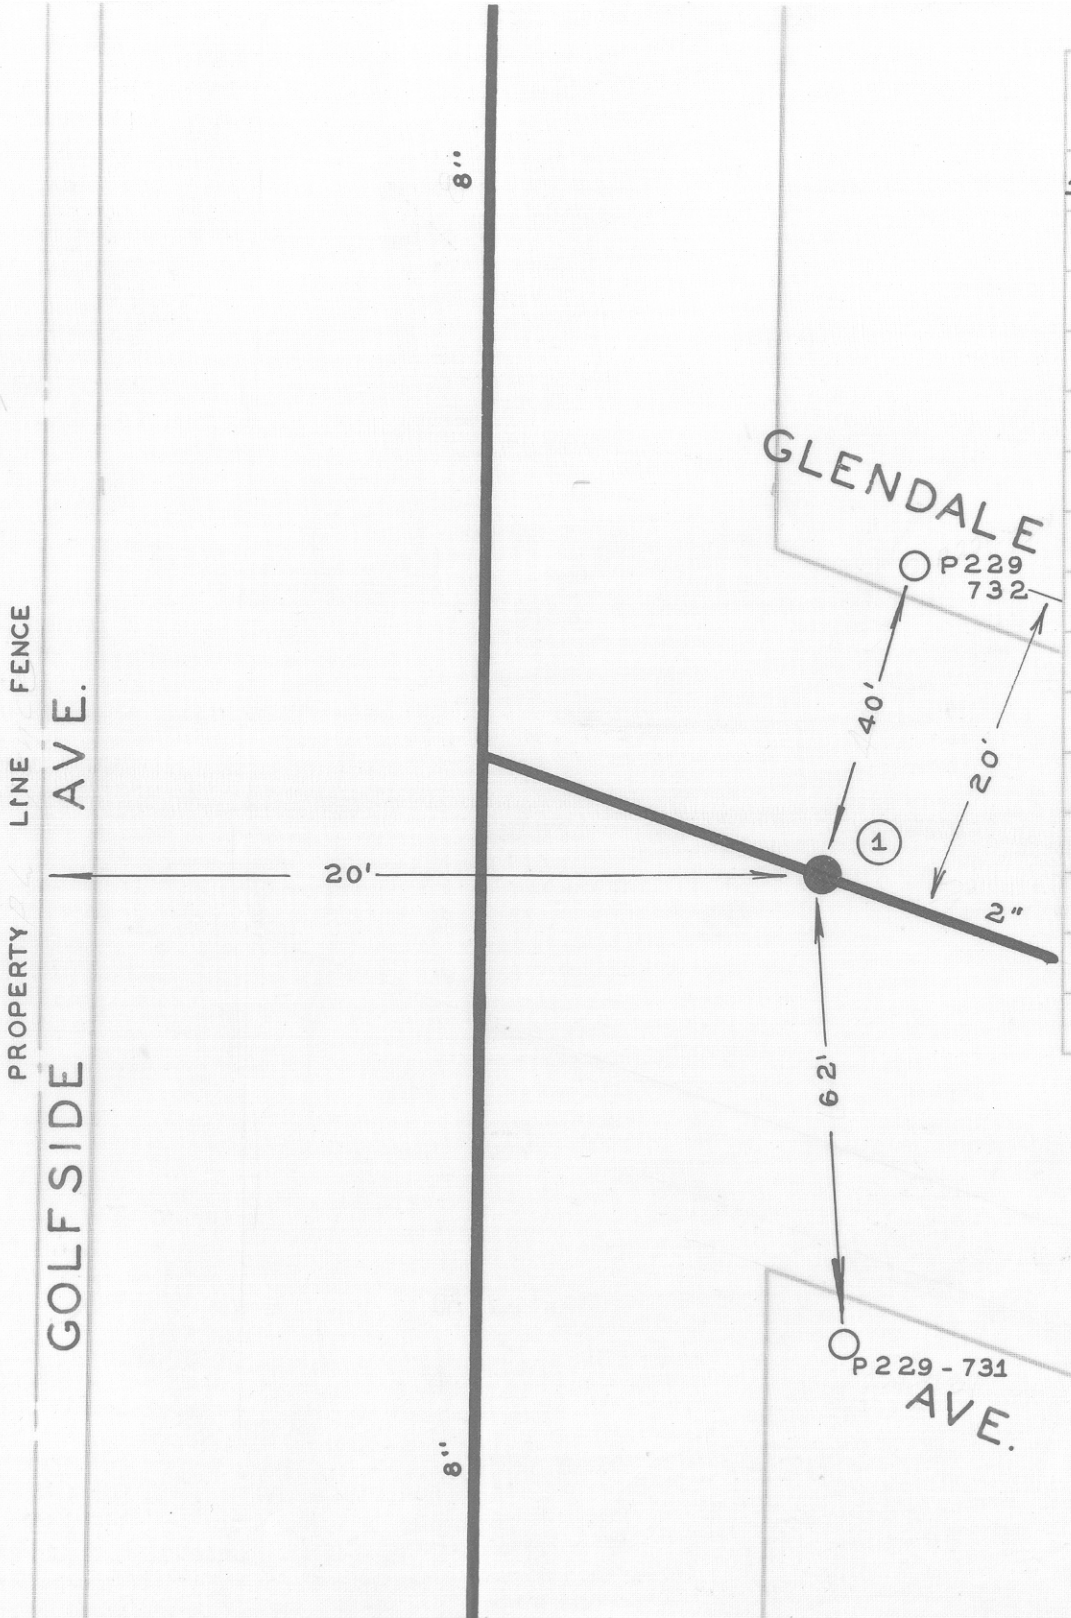

DATE	NO.	SIZE	MAKE	OPEN	TURNS
1950	1	2"	DARLING	R	7
	1	0	EPL		

CITY OF ROANOKE—WATER DEP'T

VALVE DIAGRAM

GLENDALE AVENUE &

GOLFSIDE AVENUE N W

SEC. MAP 244

DATE

PAGE NO. NW346