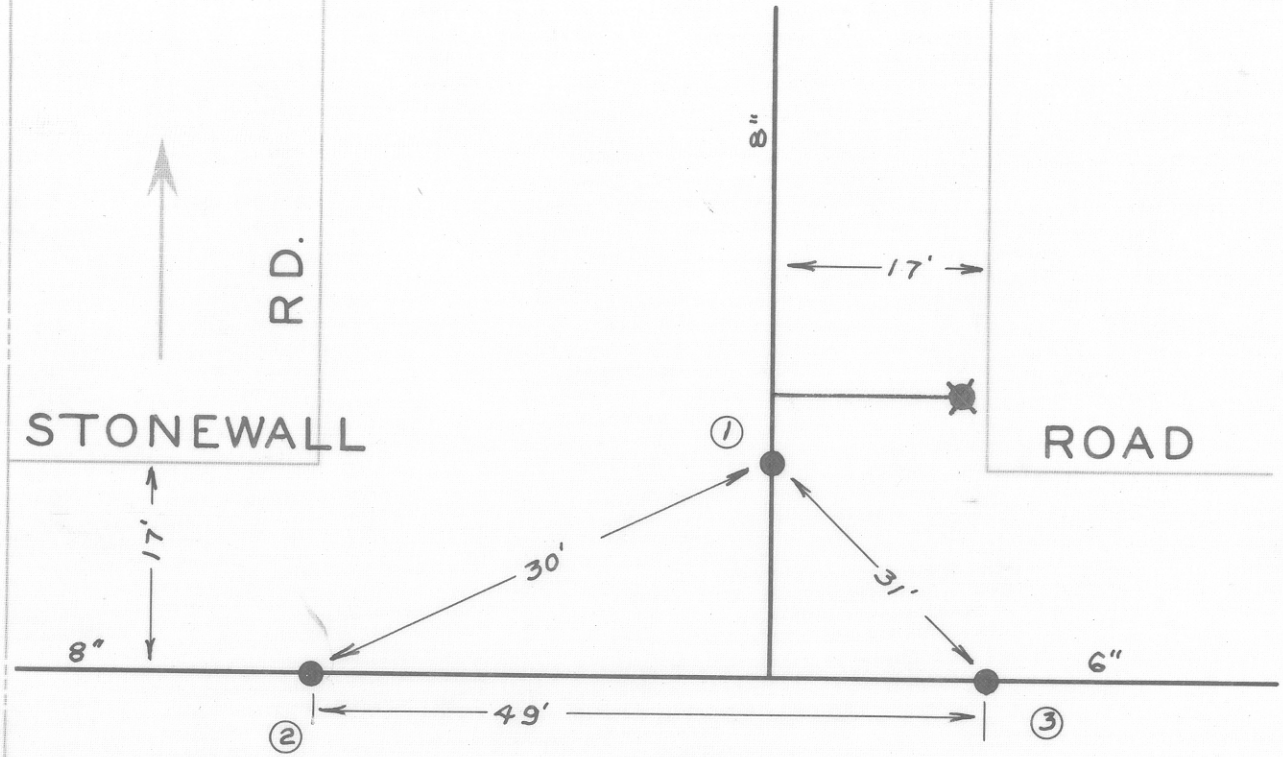

DATE	NO.	SIZE	MAKE	OPEN	TURNS
1956	1	8"	MUELLER	R	
1956	2	8"	MUELLER	R	
1956	3	6"	MUELLER	R	
	1	0	NPL		
	2	0	WPL		
	3	0	EPL		

GLEN RIDGE (CLOSED)

4502

12/2000 JH

CITY OF ROANOKE—WATER DEP'T
VALVE DIAGRAM

GLEN RIDGE RD. &
STONEWALL RD. N.W.

SEC. MAP 607 N.W.

DATE PAGE NO.