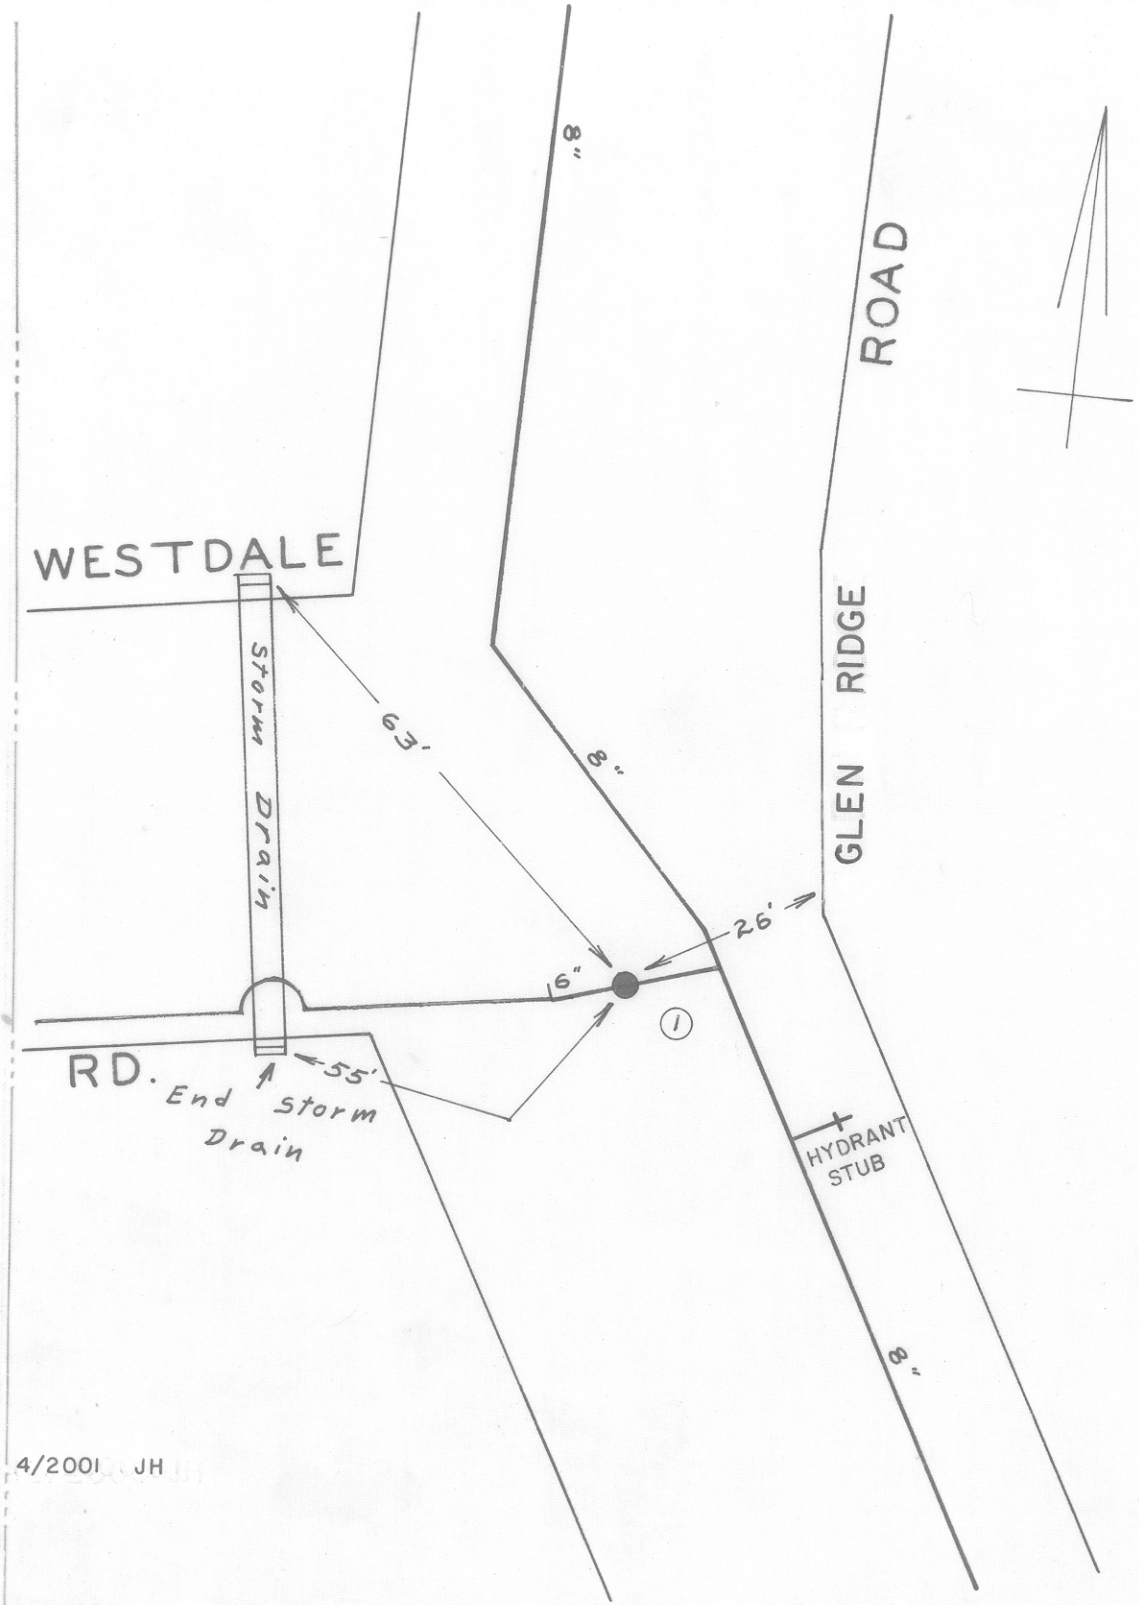

DATE	NO.	SIZE	MAKE	OPEN	TURNS
1955	1	6"	MUELLER	R	
	1	0	SPL		

CITY OF ROANOKE — WATER DEPT.

VALVE DIAGRAM

GLEN RIDGE ROAD &

WESTDALE RD. N.W.

SEC. MAP 607 N.W.

DATE PAGE NO.

4/2001 JH

"IMPERIAL" TRACING CLOTH.
K & E CO., N. Y.