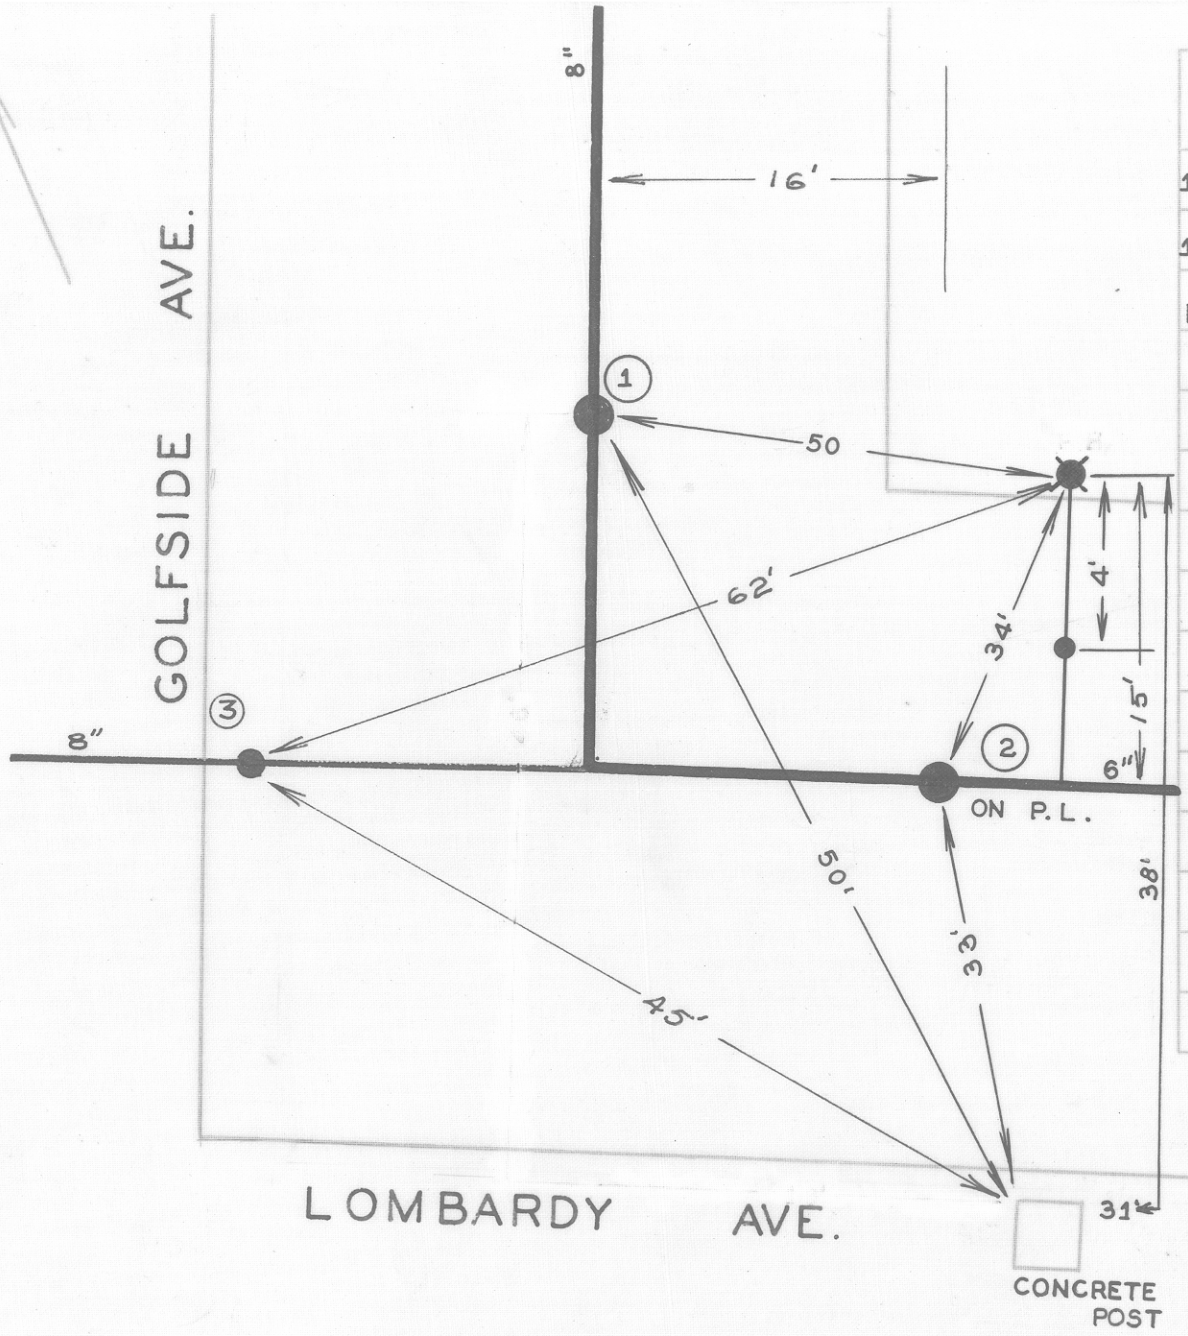

DATE	NO.	SIZE	MAKE	OPEN	TURNS
1950	1	8"	DARLING	R	27
1950	2	6"	DARLING	R	20
1952	3	8"	MUELLER	R	27
	1	0	NPL		
	2	0	EPL		
	3	3'-E	WPL		

CITY OF ROANOKE—WATER DEP'T

VALVE DIAGRAM

GOLFSIDE AVENUE &
LOMBARDY AVENUE

SEC. MAP 244 N. W.

DATE PAGE NO. NW272

12/2000 JH