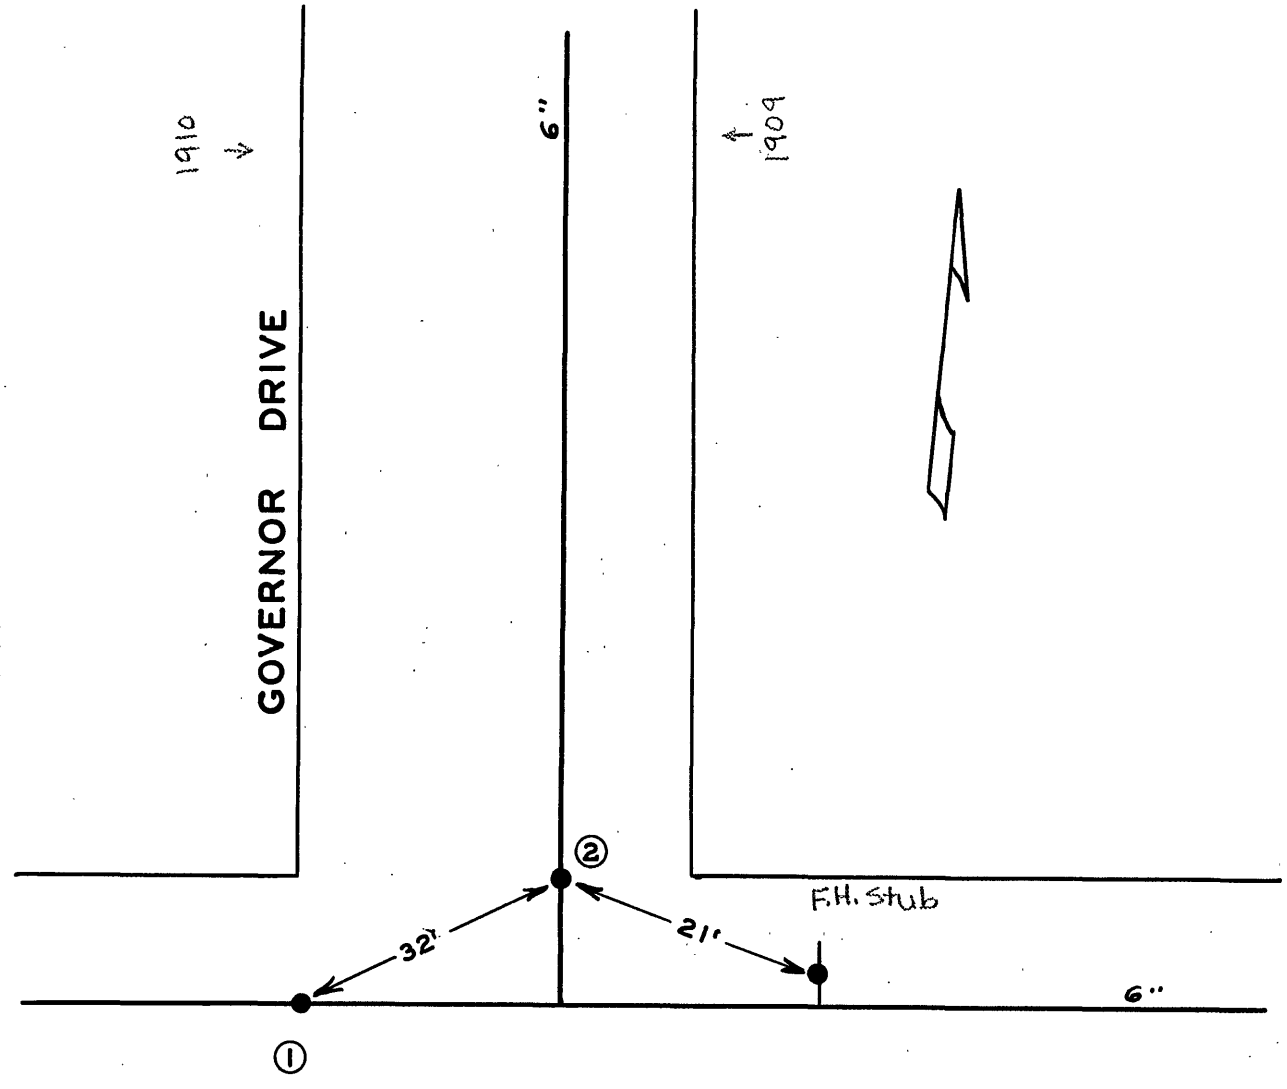

DATE	NO.	SIZE	MAKE	OPEN	TURNS
11-64	1	6"	DARLING	R	21
11-64	2	6"	DARLING	R	21

CITY OF ROANOKE — WATER DEPT.

VALVE DIAGRAM

GOVERNOR DRIVE &

JANDA DRIVE N.W.

SEC. MAP 47 Roanoke County

DATE PAGE NO.