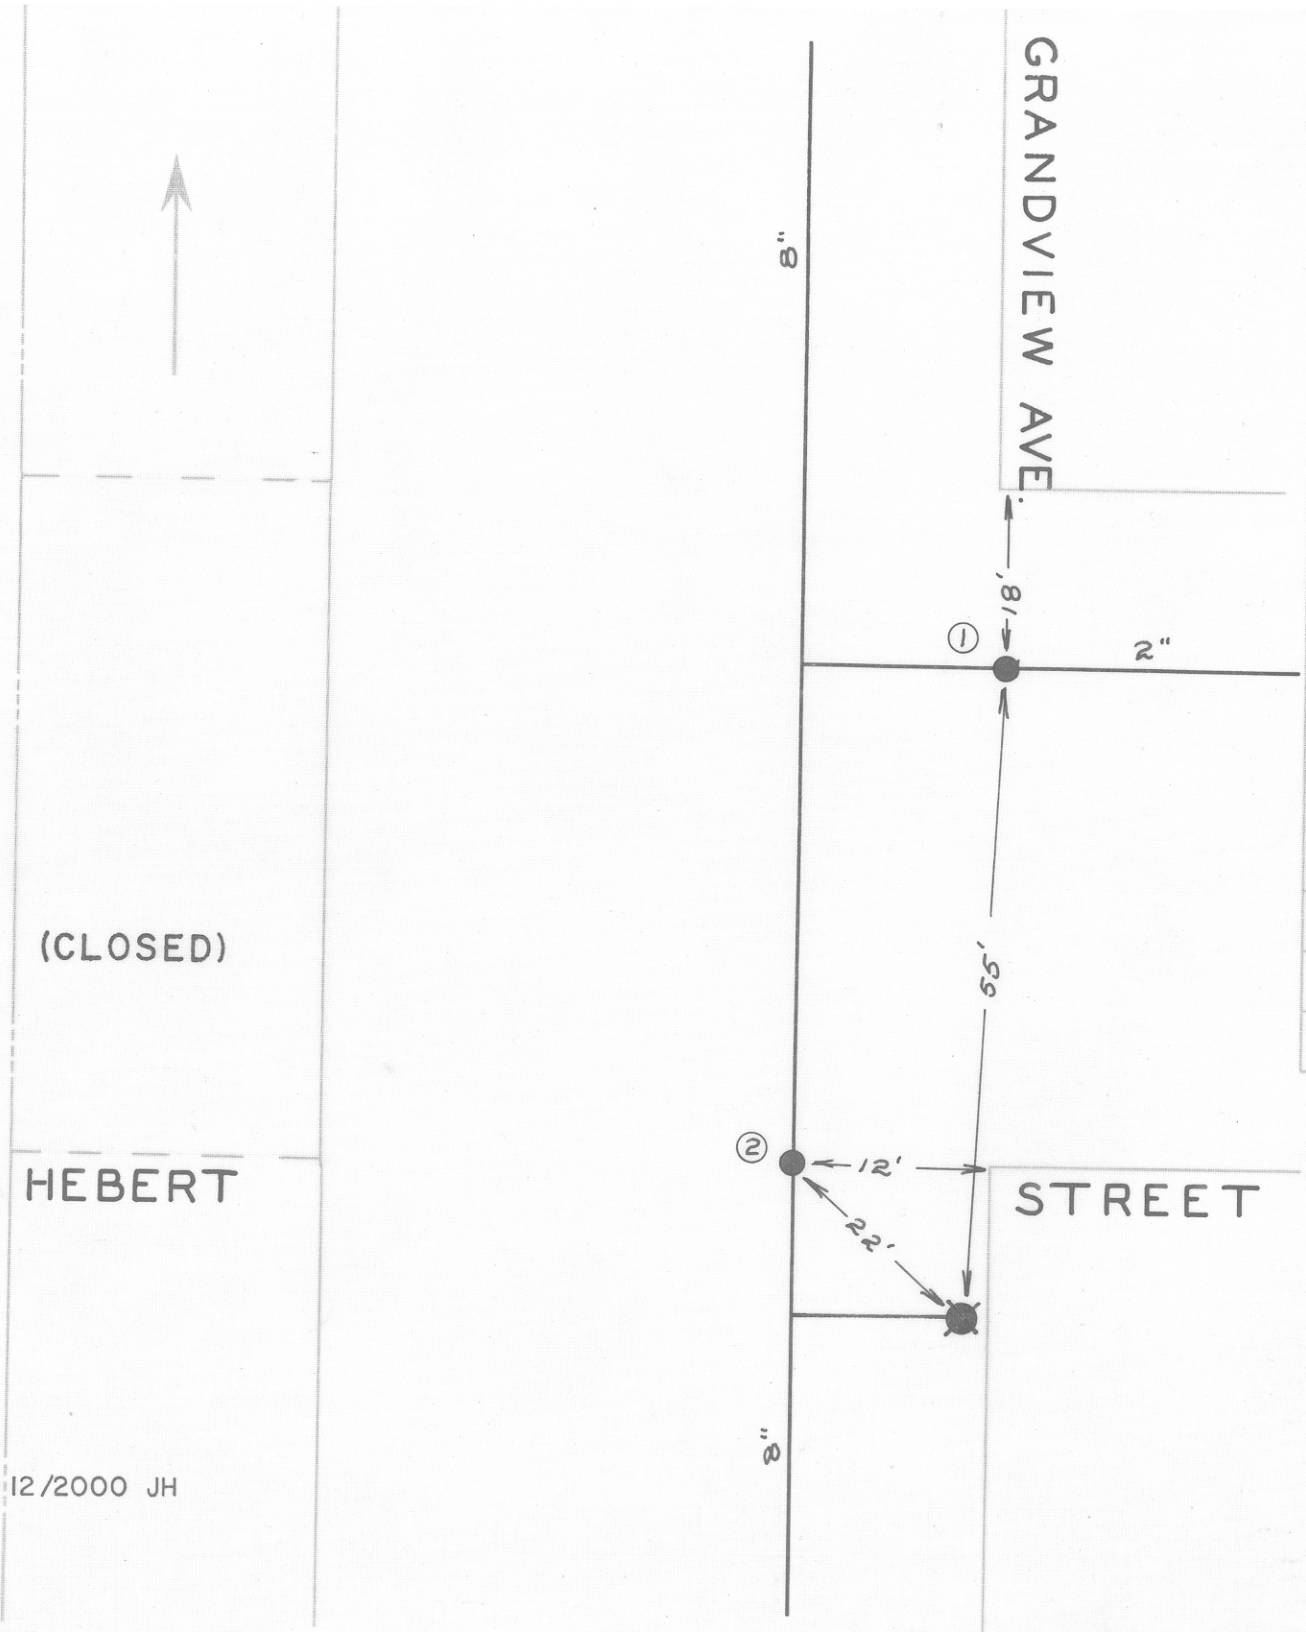

DATE	NO.	SIZE	MAKE	OPEN	TURNS
1955	1	2"	DARLING	R	7
1955	2	8"	MUELLER	R	27
	1	0	EPL		
	2	0	SPL		

CITY OF ROANOKE — WATER DEP'T

VALVE DIAGRAM

GRANDVIEW AVE. &

HEBERT ST. N.W.

SEC. MAP 227 N.W.

DATE PAGE NO.