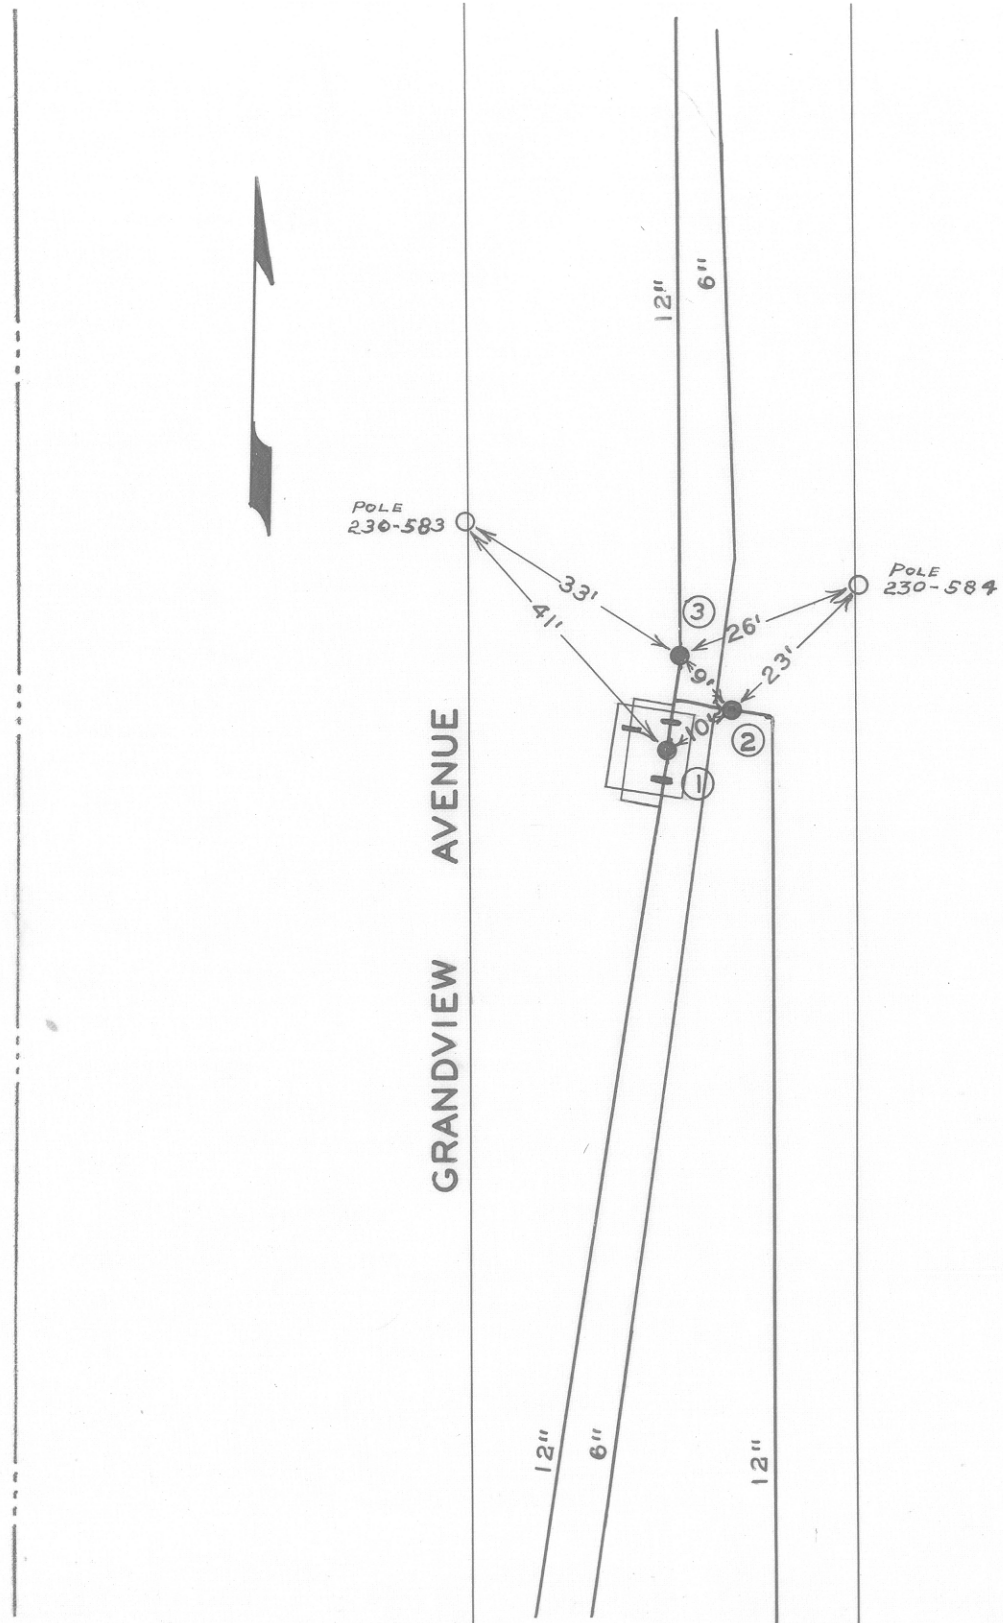

DATE	NO.	SIZE	MAKE	OPEN	TURNS
	1	12"	PRESSURE	VALVE	
	2	12"			
	3	12"			

CITY OF ROANOKE – WATER DEPT.
VALVE DIAGRAM
GRANDVIEW AVENUE N.W.
PRESSURE VALVE NEAR
ROUND TOP ROAD
SEC. MAP 216
DATE PAGE NO.