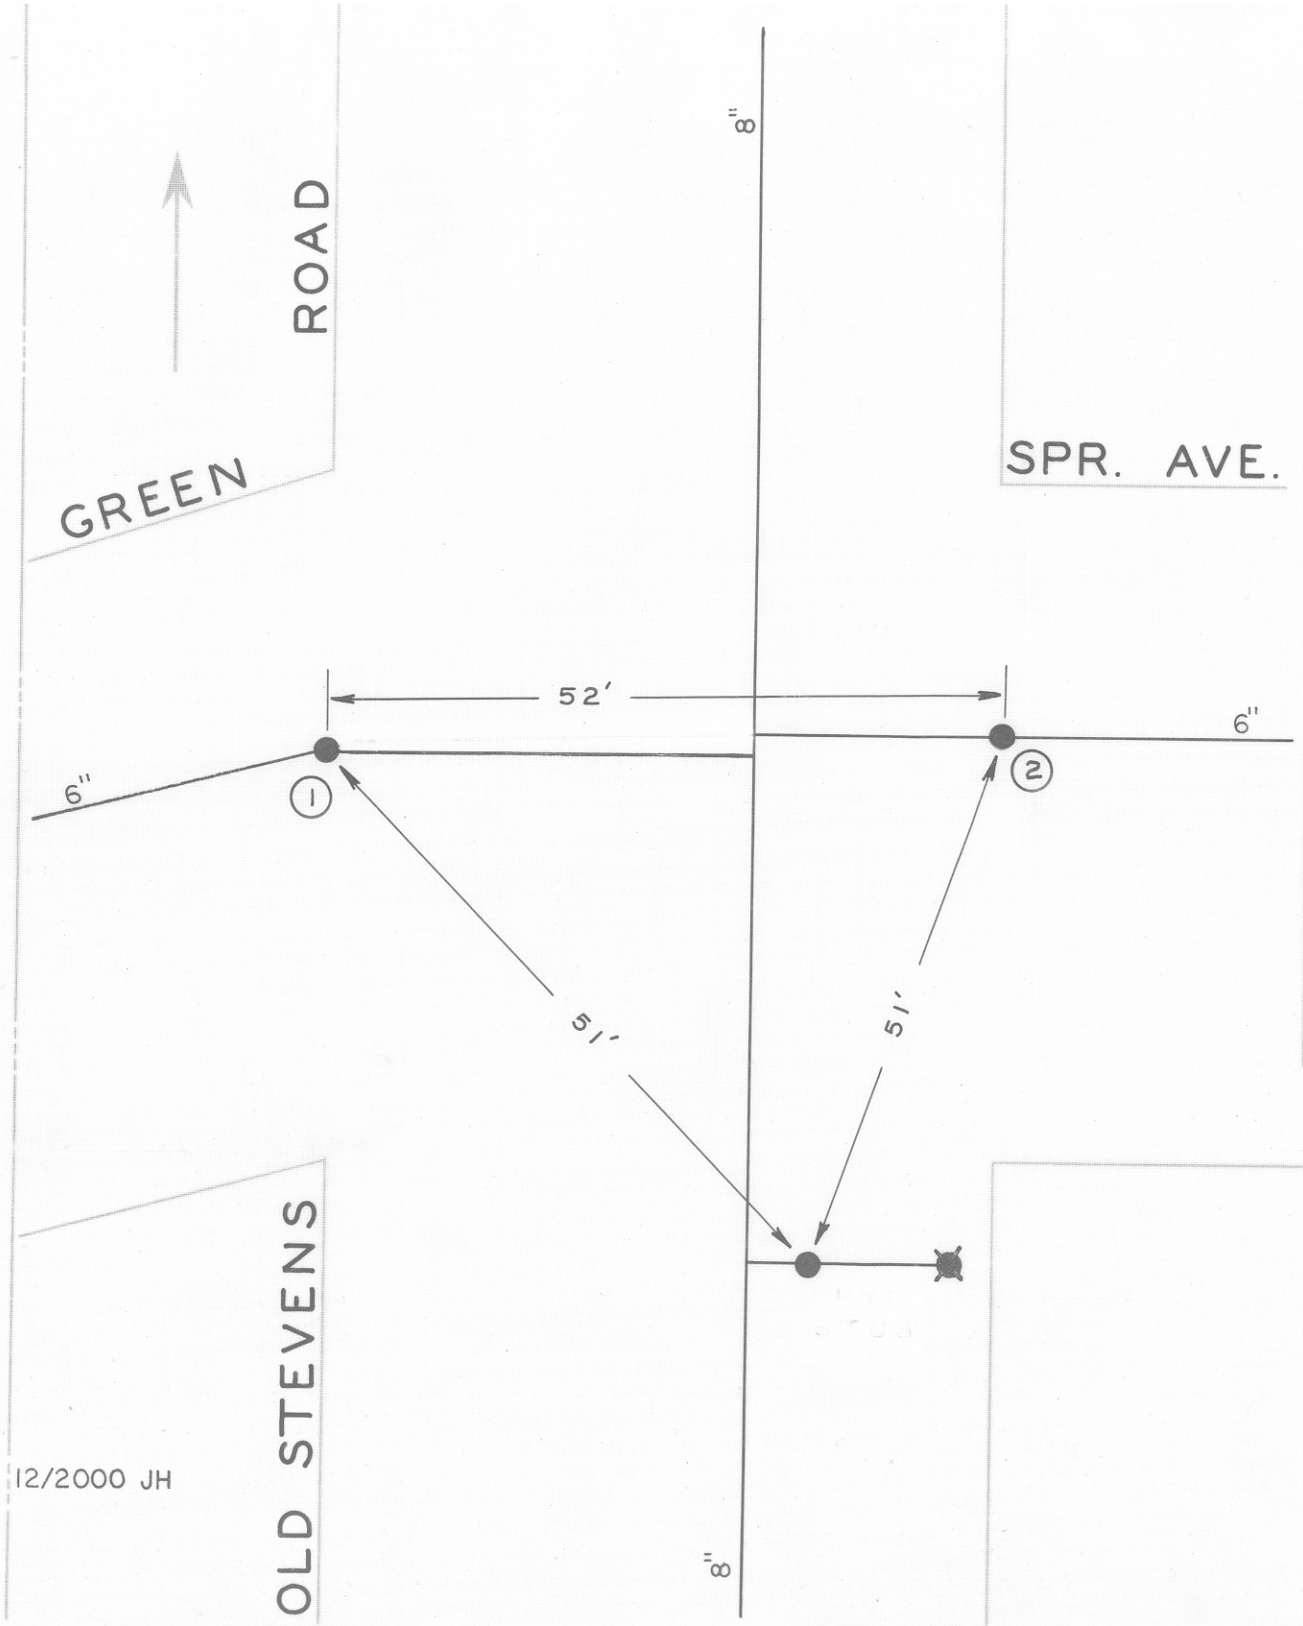

DATE	NO.	SIZE	MAKE	OPEN	TURNS
'61	1	6"	MUE.	R	20
'61	2	6"	MUE.	R	20
	1	0	WPL		
	2	0	EPL		

12/2000 JH

CITY OF ROANOKE—WATER DEP'T

VALVE DIAGRAM

GREEN SPRING AVE. &

OLD STEVENS RD. N.W.

SEC. MAP 273 N.W.

DATE PAGE NO.