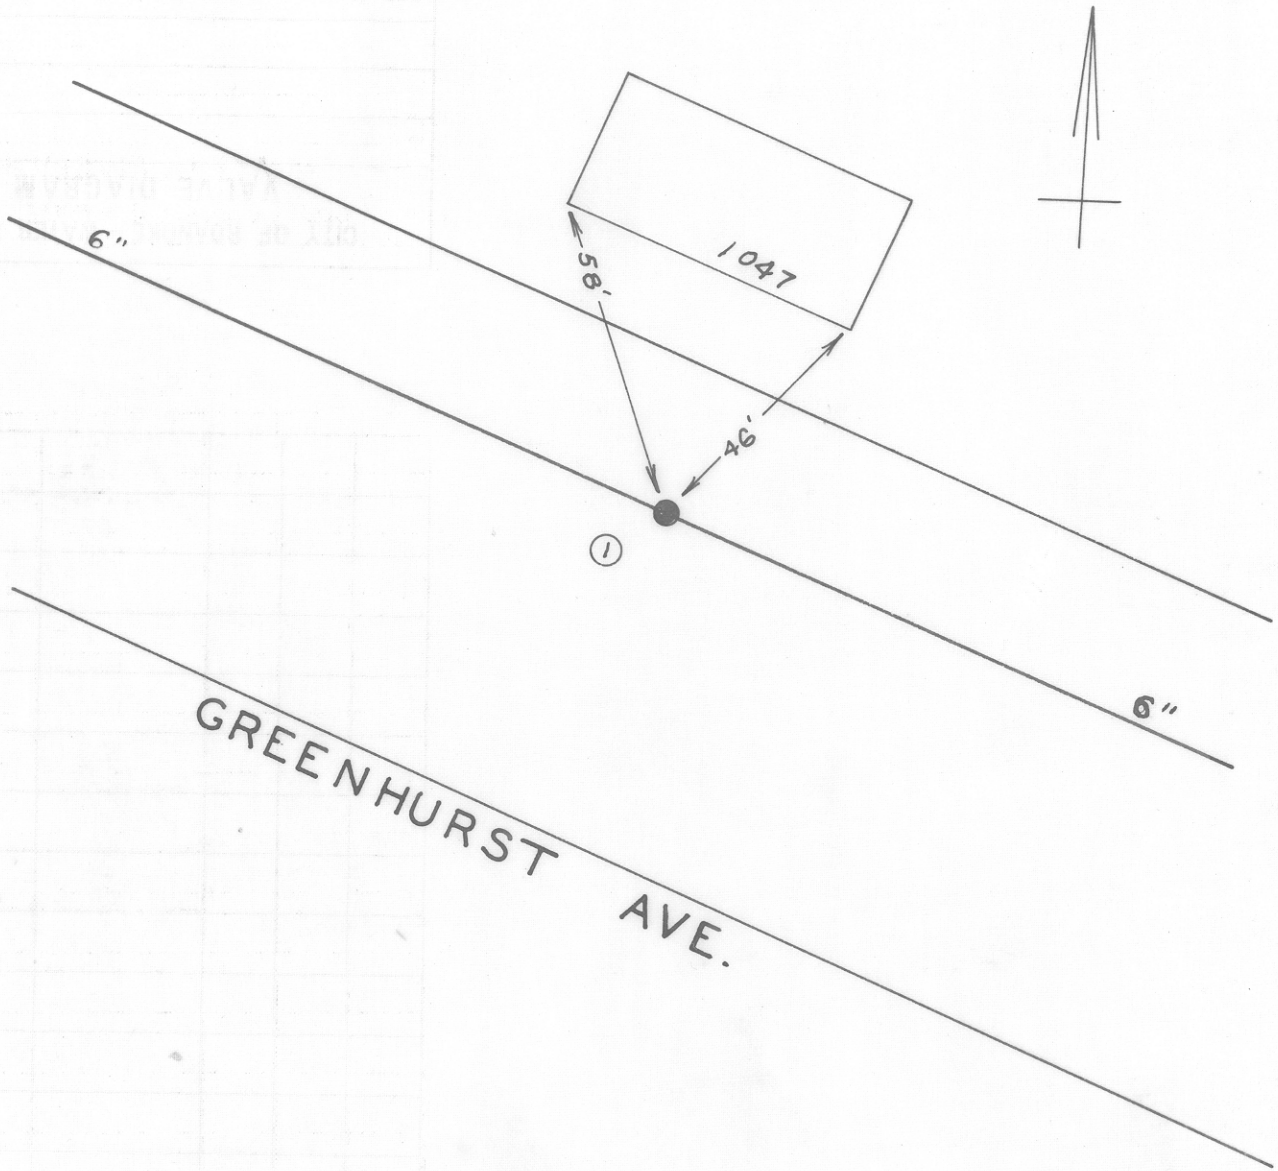

DATE	NO.	SIZE	MAKE	OPEN	TURNS
5-64	1	6"			
	1	230'-E	EPL	COURT	ST.

CITY OF ROANOKE — WATER DEPT.

VALVE DIAGRAM

GREENHURST AVE. 230'

E. OF COURT ST. N.W.

SEC. MAP 214

DATE PAGE NO.

"IMPERIAL" TRACING CLOTH.
K & E CO., N. Y.