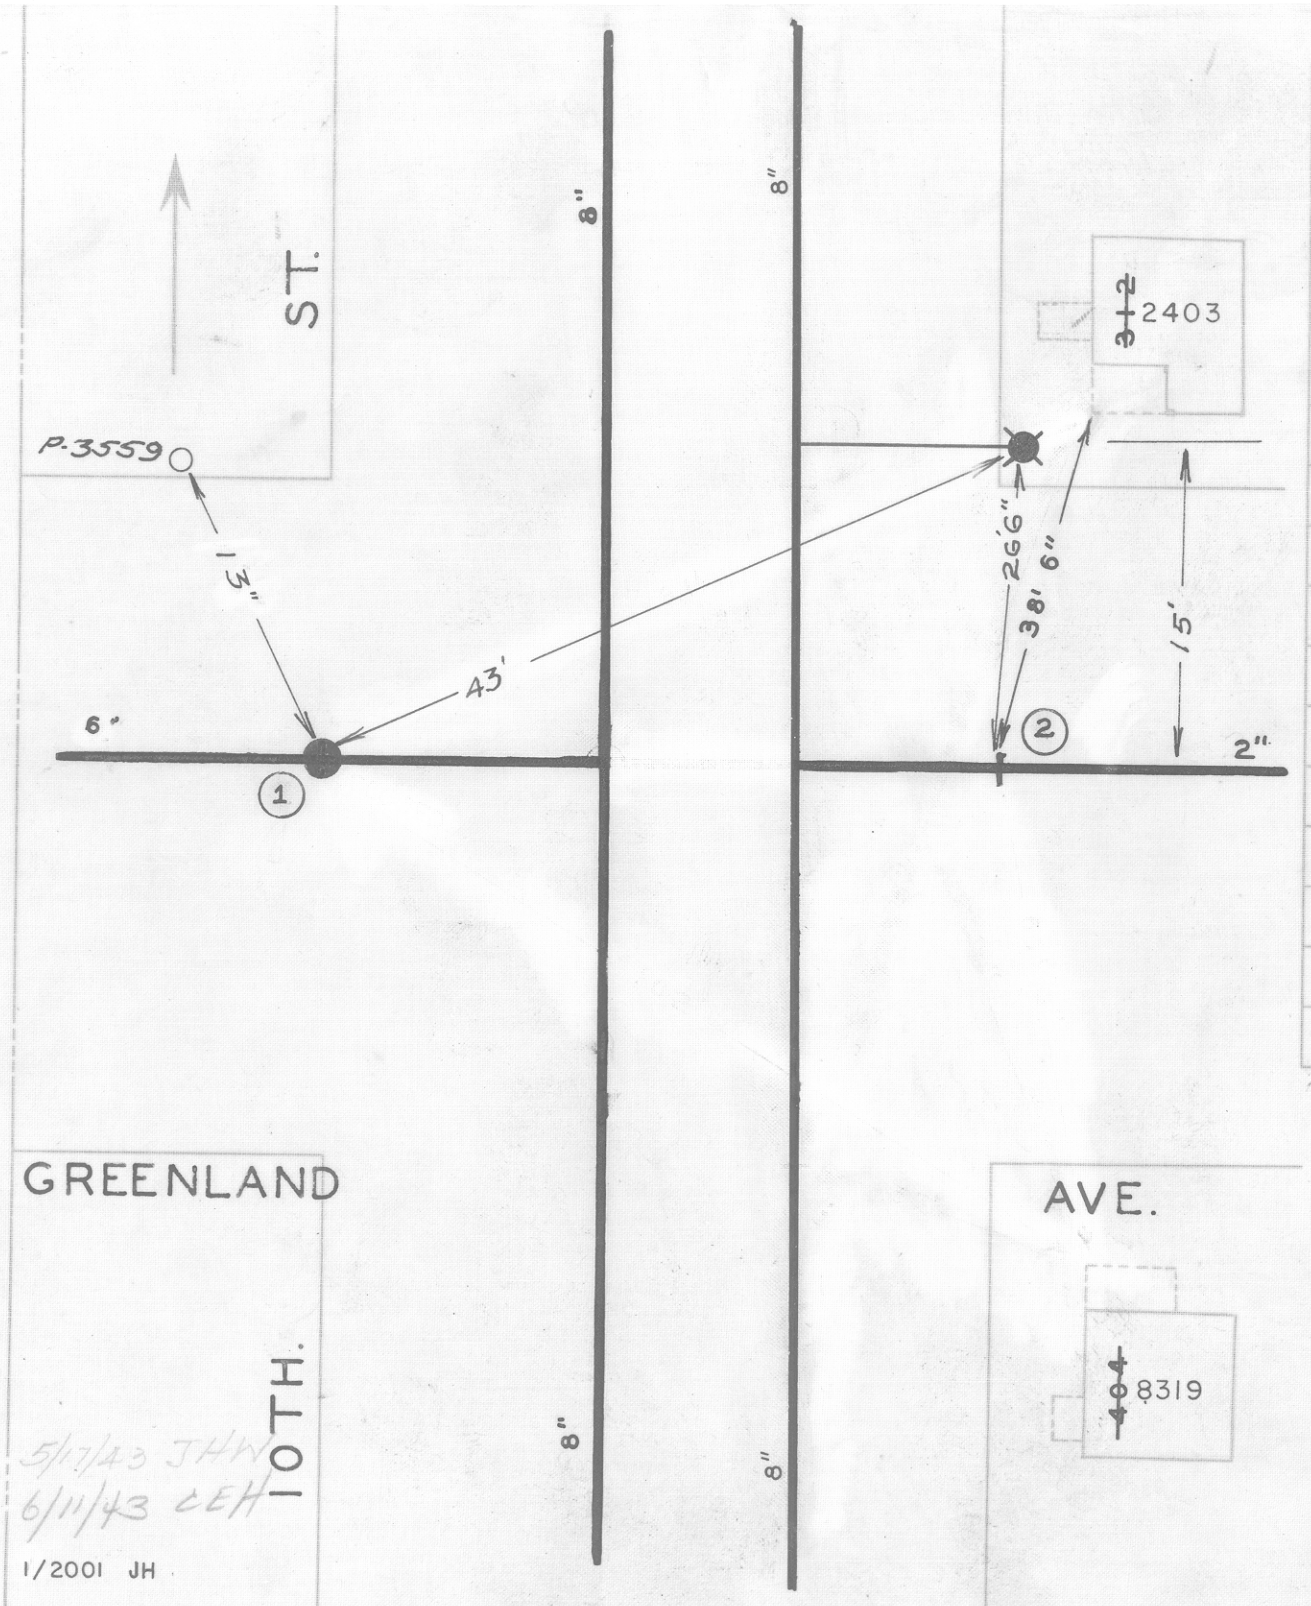

DATE	NO.	SIZE	MAKE	OPEN	TURNS
5-64	1	6"	MUELLER	R	
1927	2	2"		L	9
	1	0	WPL		
	2	4'-W	EPL		

5/17/43 JHW
6/11/43 CEH

1/2001 JH

CITY OF ROANOKE—WATER DEP'T
VALVE DIAGRAM

GREENLAND AVE. & 10TH.
10 TH STREET

SEC. MAP 215 N. W.

DATE PAGE NO N.W. 76