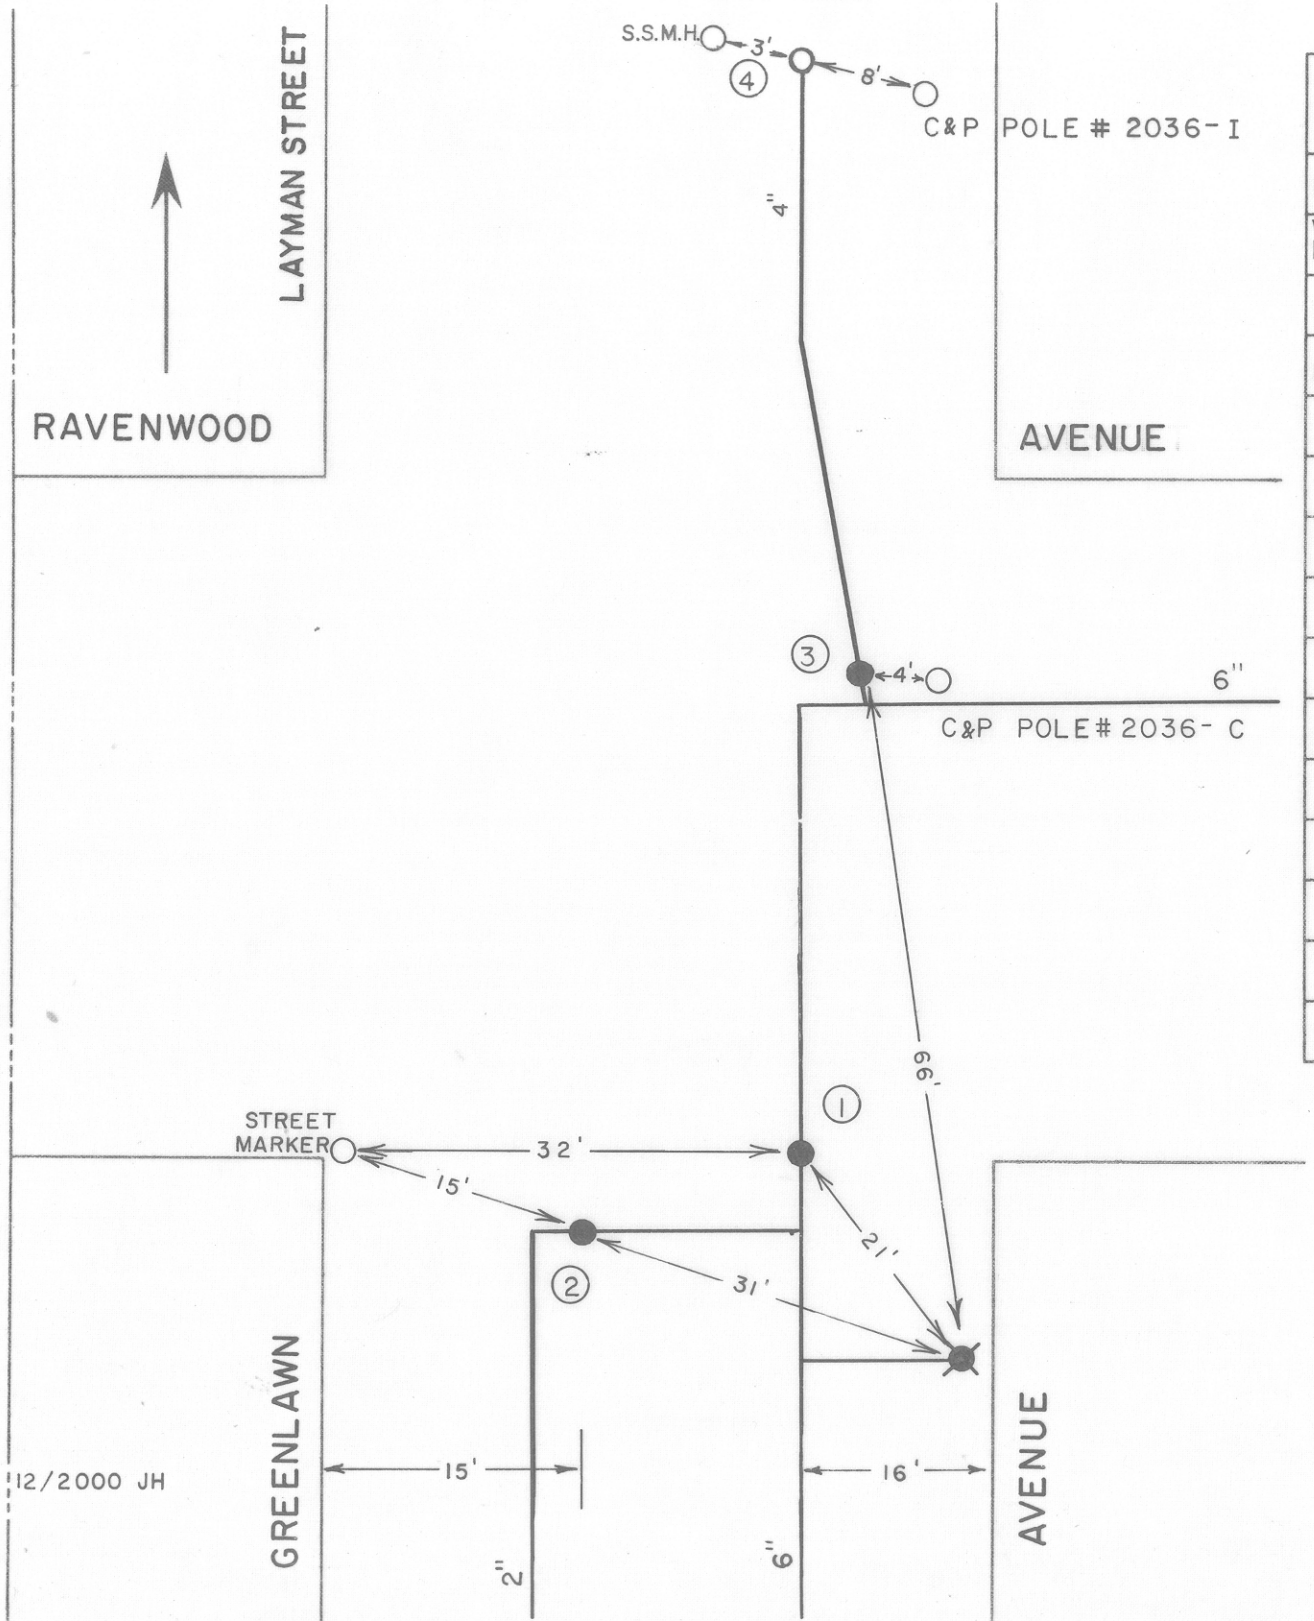

DATE	NO.	SIZE	MAKE	OPEN	TURNS
1953	1	6"		R	
W.R. 1951	2	2"		R	
1982	3	4"	MUELLER	R	15
1982	4	2"	BLOW OFF	R	
	1	0	SPL		
	2	3'-S	SPL		

CITY OF ROANOKE—WATER DEP'T

VALVE DIAGRAM

GREENLAWN AVE. &

LAYMAN ST. &

RAVENWOOD AVENUE

SEC. MAP 216 N.W.

DATE PAGE NO.