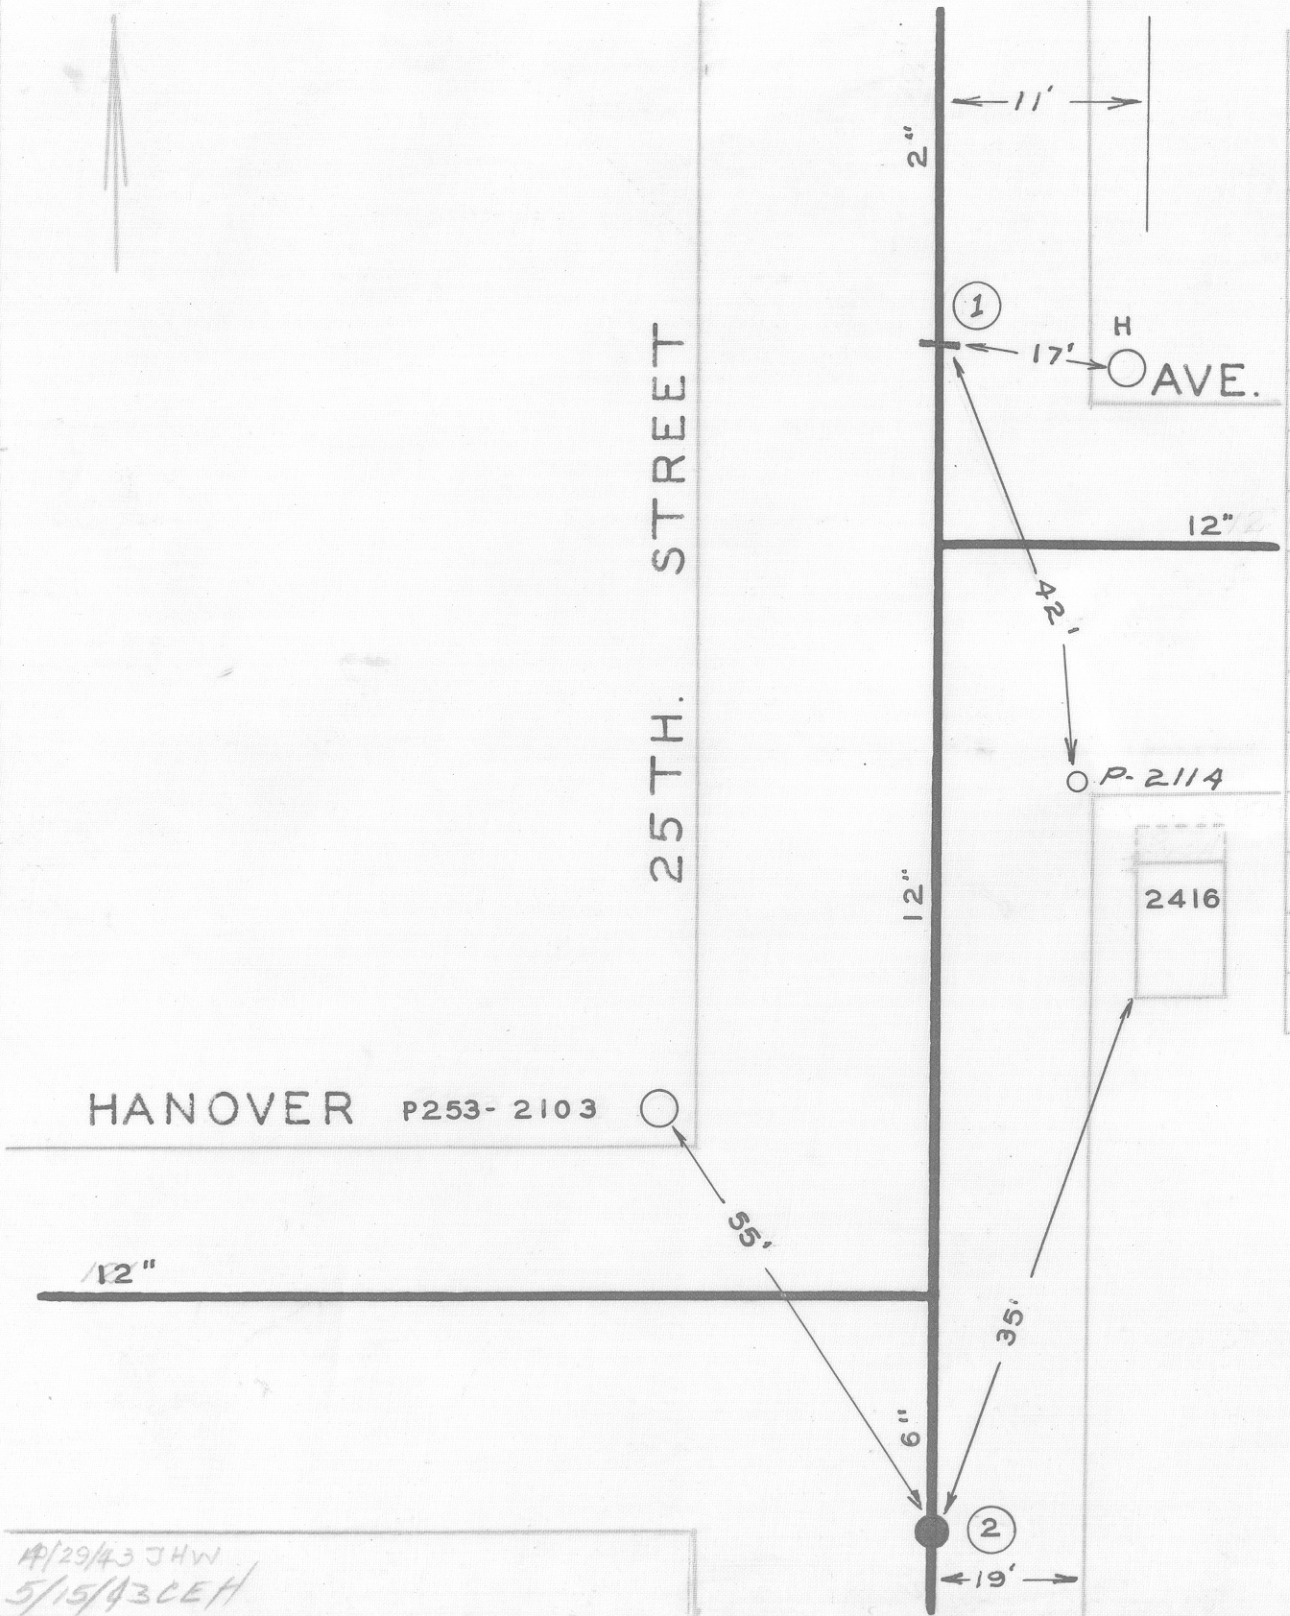

DATE	NO.	SIZE	MAKE	OPEN	TURNS
1930	1	2"		R	9
1926	2	6"		R	20
	1	0	NPL		
	2	0	SPL		

CITY OF ROANOKE—WATER DEP'T

VALVE DIAGRAM

HANOVER AVE. & 25TH. ST. N. W.

SEC. MAP 232

DATE

PAGE NO. NW217

4/29/43 JHW
5/15/43 CEH