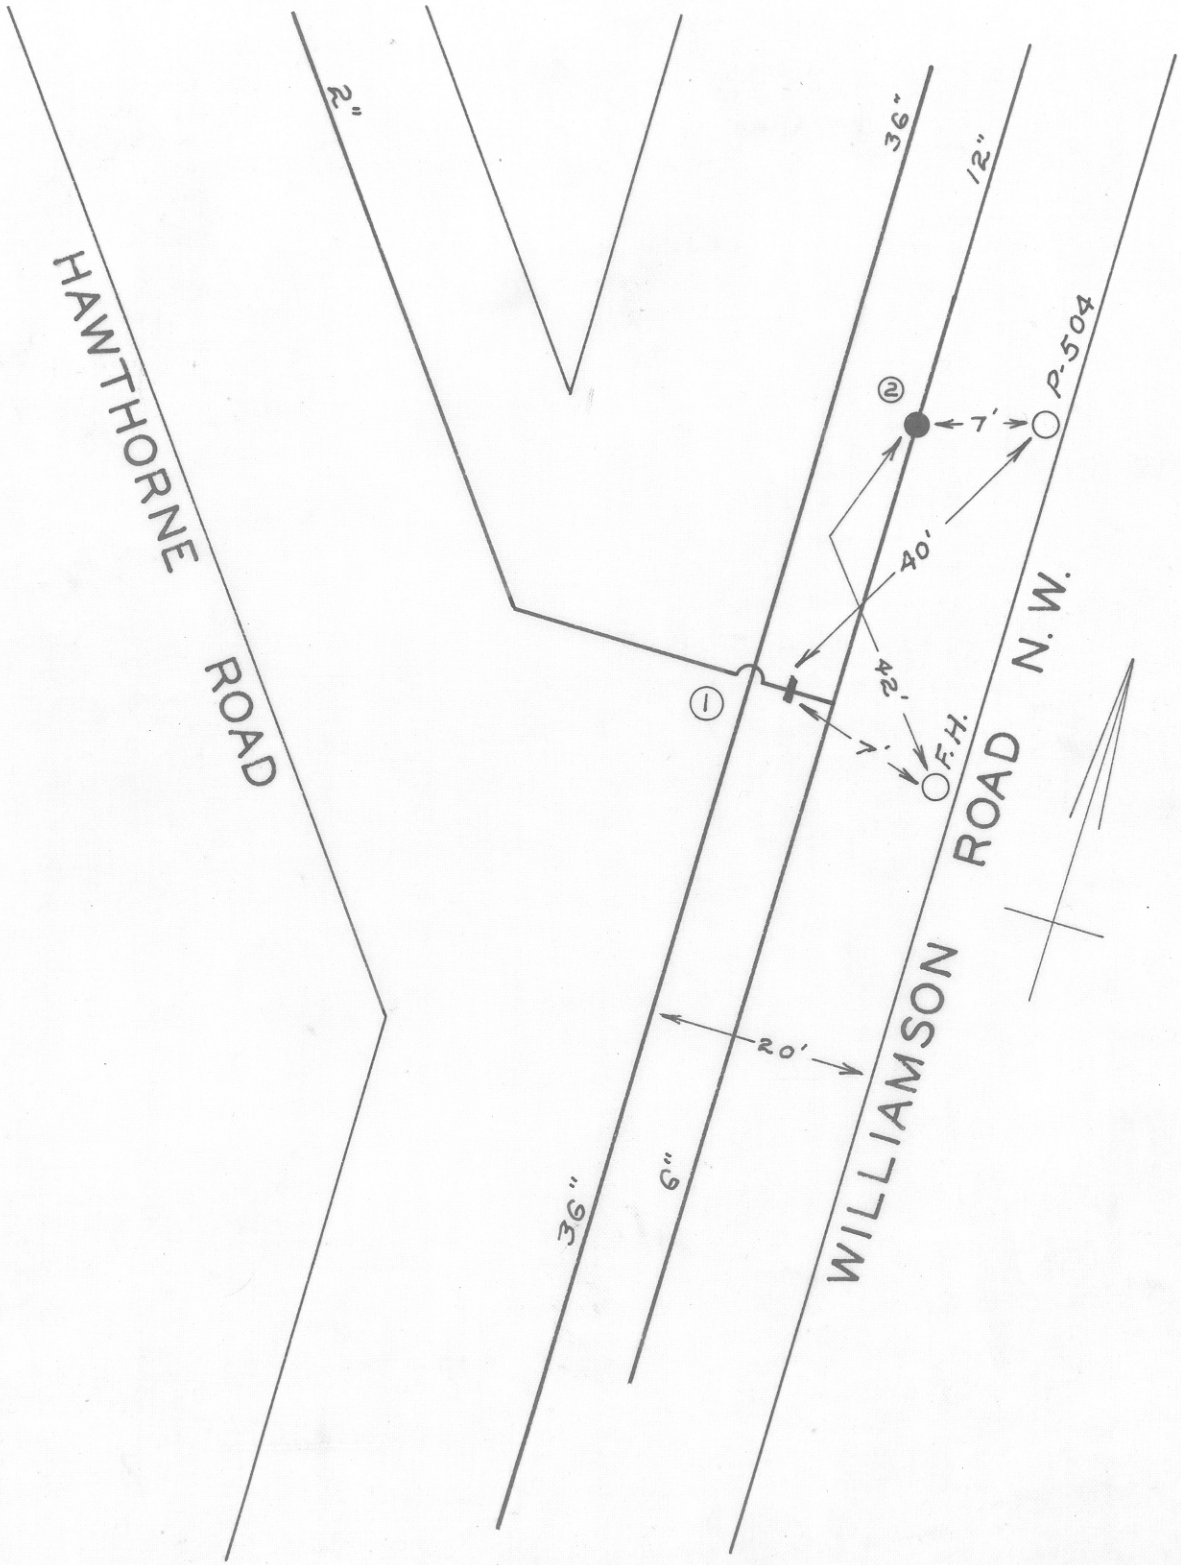

DATE	NO.	SIZE	MAKE	OPEN	TURNS
	1	2"			
	1	12"	MUELLER	R	
	1	27'-N	NPL		
		52'-E	WPL		
	2	15'-N	NPL		

CITY OF ROANOKE — WATER DEPT.

VALVE DIAGRAM

HAWTHORNE RD. &

WILLIAMSON RD. N.W.

SEC. MAP 219

DATE PAGE NO.

"IMPERIAL" TRACING CLOTH
K & E CO., N. Y.