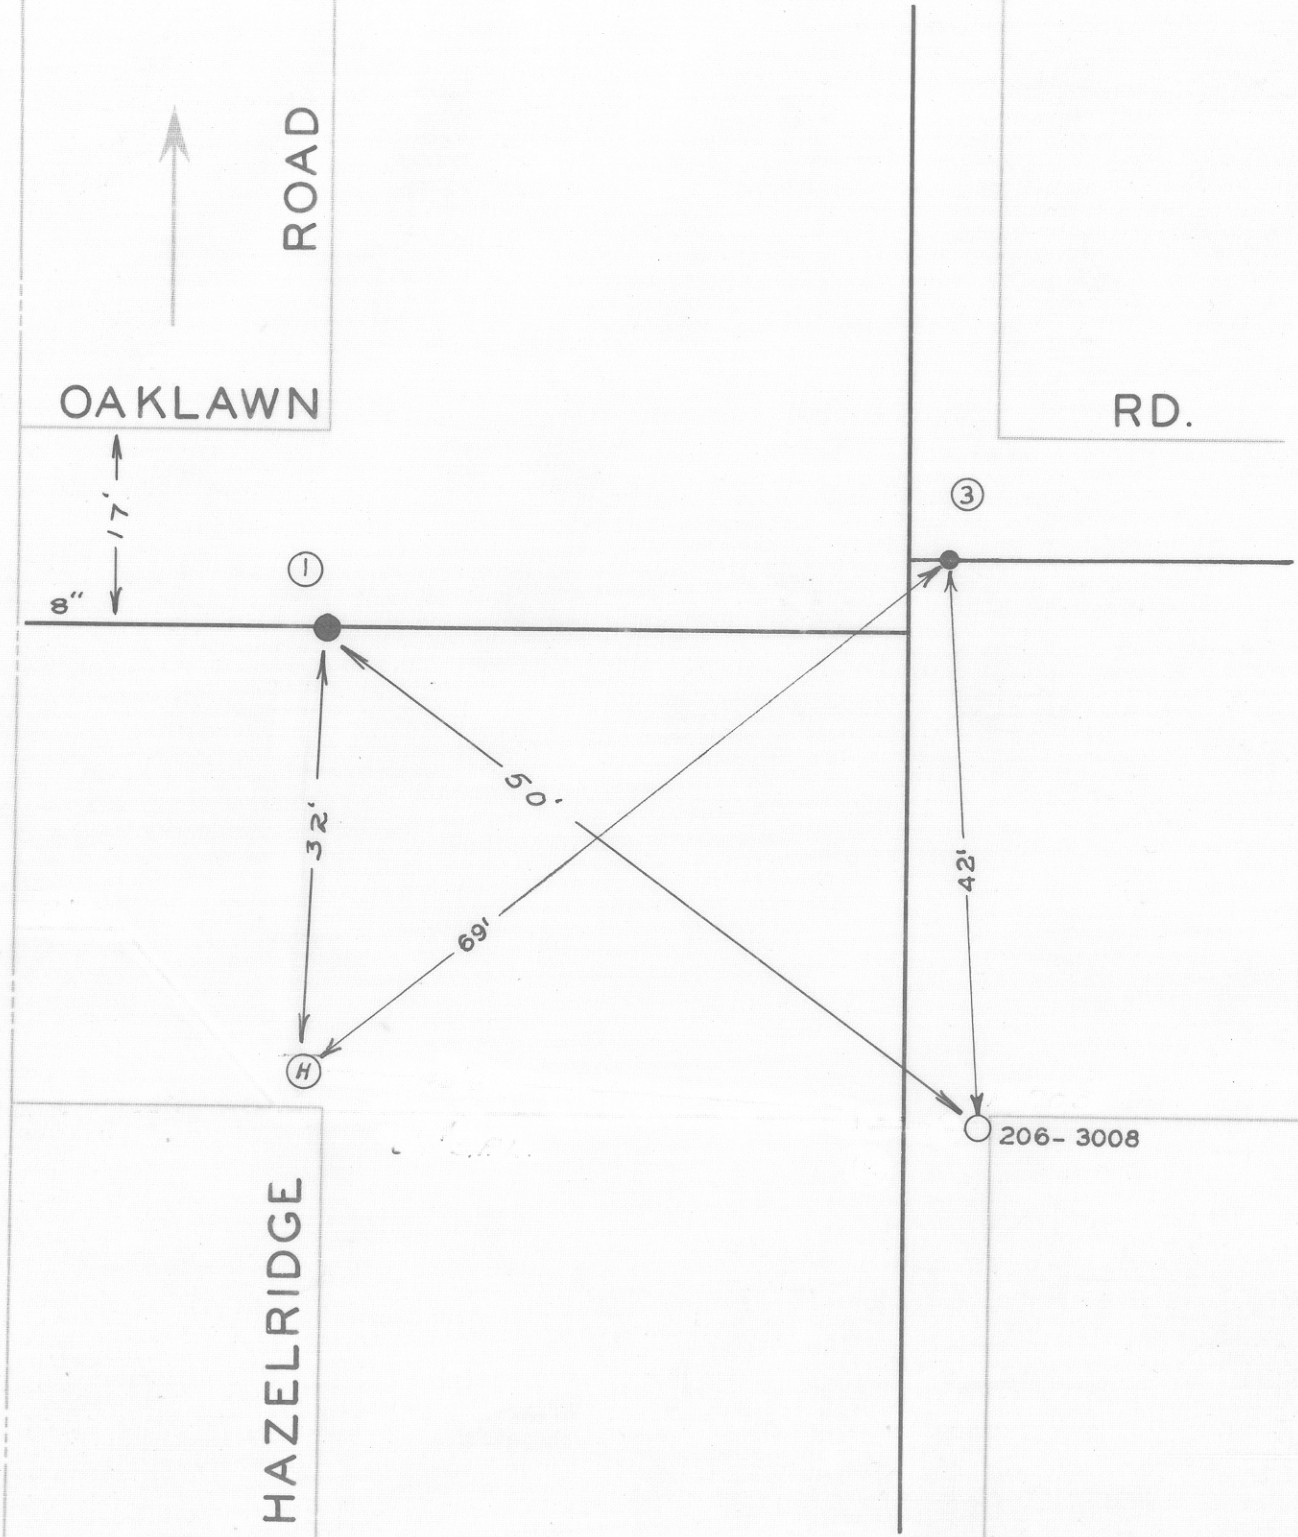

DATE	NO.	SIZE	MAKE	OPEN	TURNS
1953	1	8"			
8-62	3	6"	DARLING	R	
	1	0	WPL		
	3	9"W	EPL		

CITY OF ROANOKE—WATER DEP'T

VALVE DIAGRAM

HAZELRIDGE RD. &

OAKLAWN RD. N.W.

SEC. MAP 218

DATE PAGE NO.