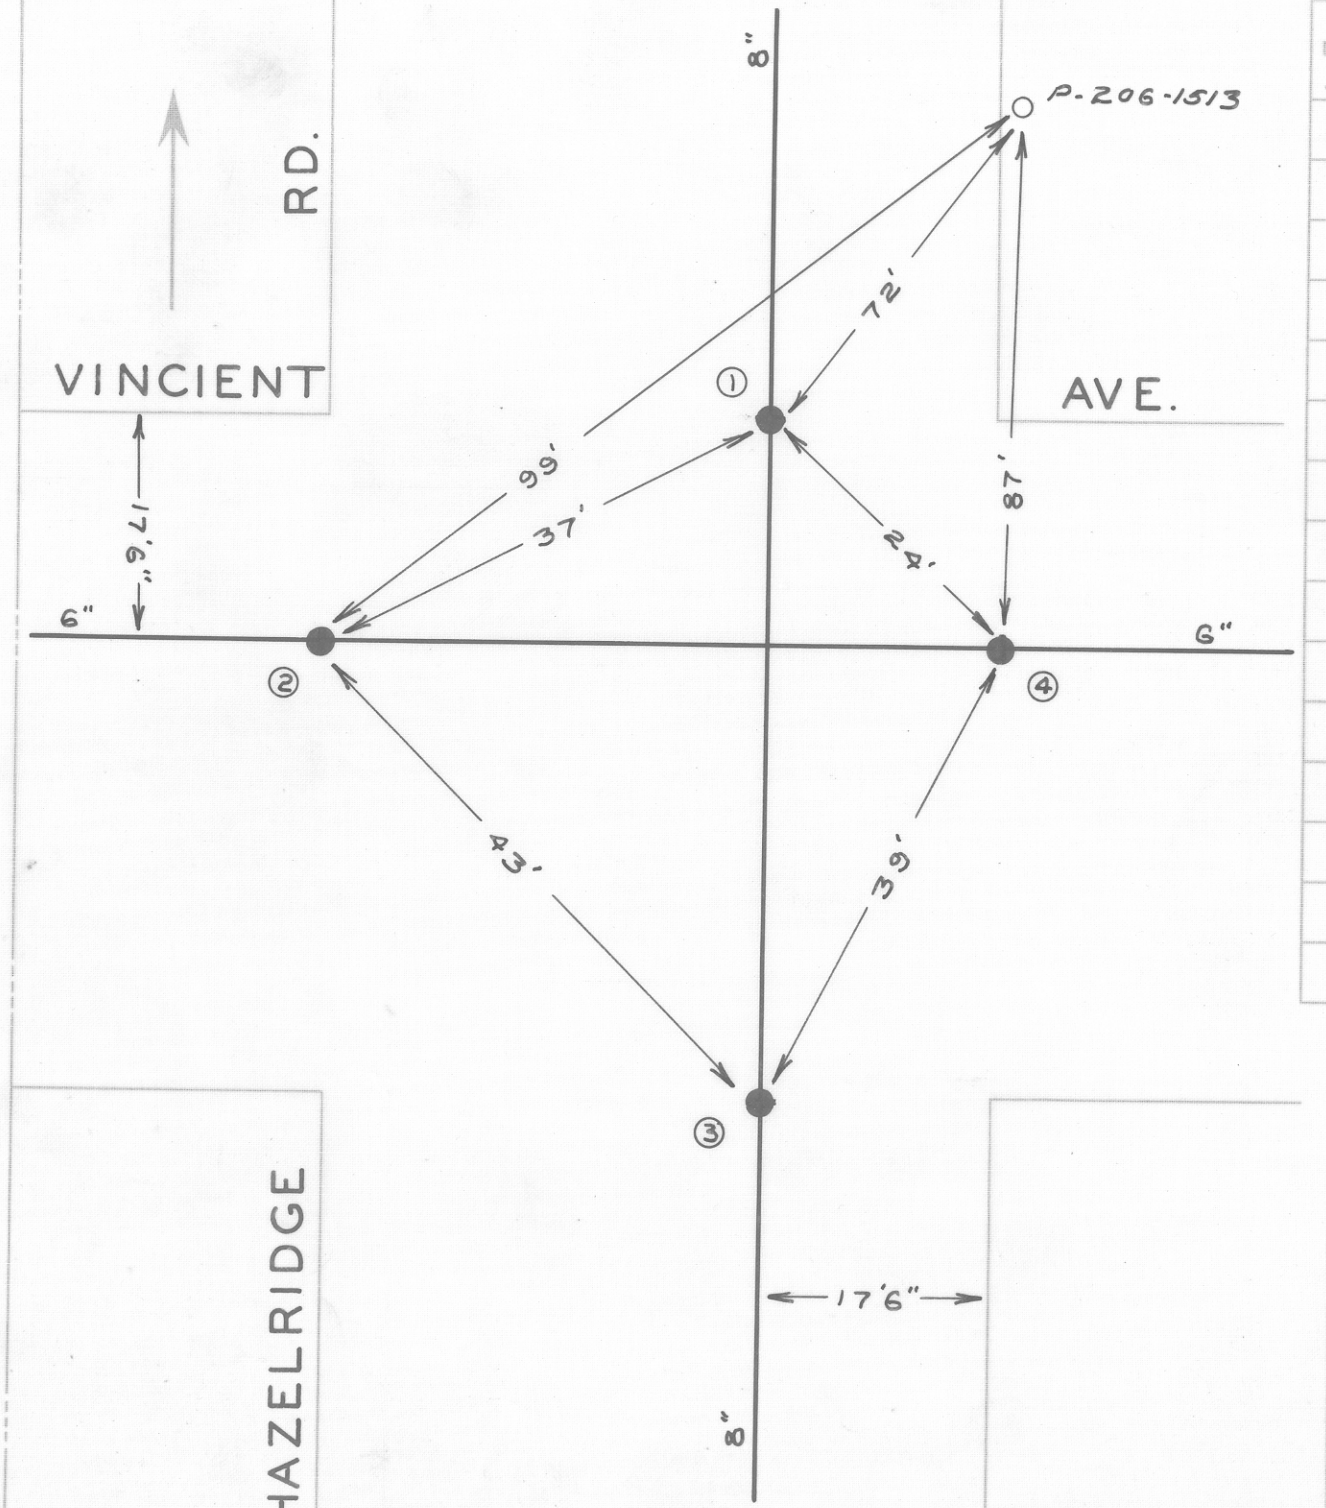

DATE	NO.	SIZE	MAKE	OPEN	TURNS
	1	8"	DARLING	R	
	2	6"	MUELLER	R	
	3	8"	DARLING	R	
	4	6"	MUELLER	R	
	1	0	NPL		
	2	0	WPL		
	3	0	SPL		
	4	0	EPL		

CITY OF ROANOKE—WATER DEP'T

VALVE DIAGRAM

HAZELRIDGE ROAD &

VINCIENT AVE. N.W.

SEC. MAP 210

DATE PAGE NO.