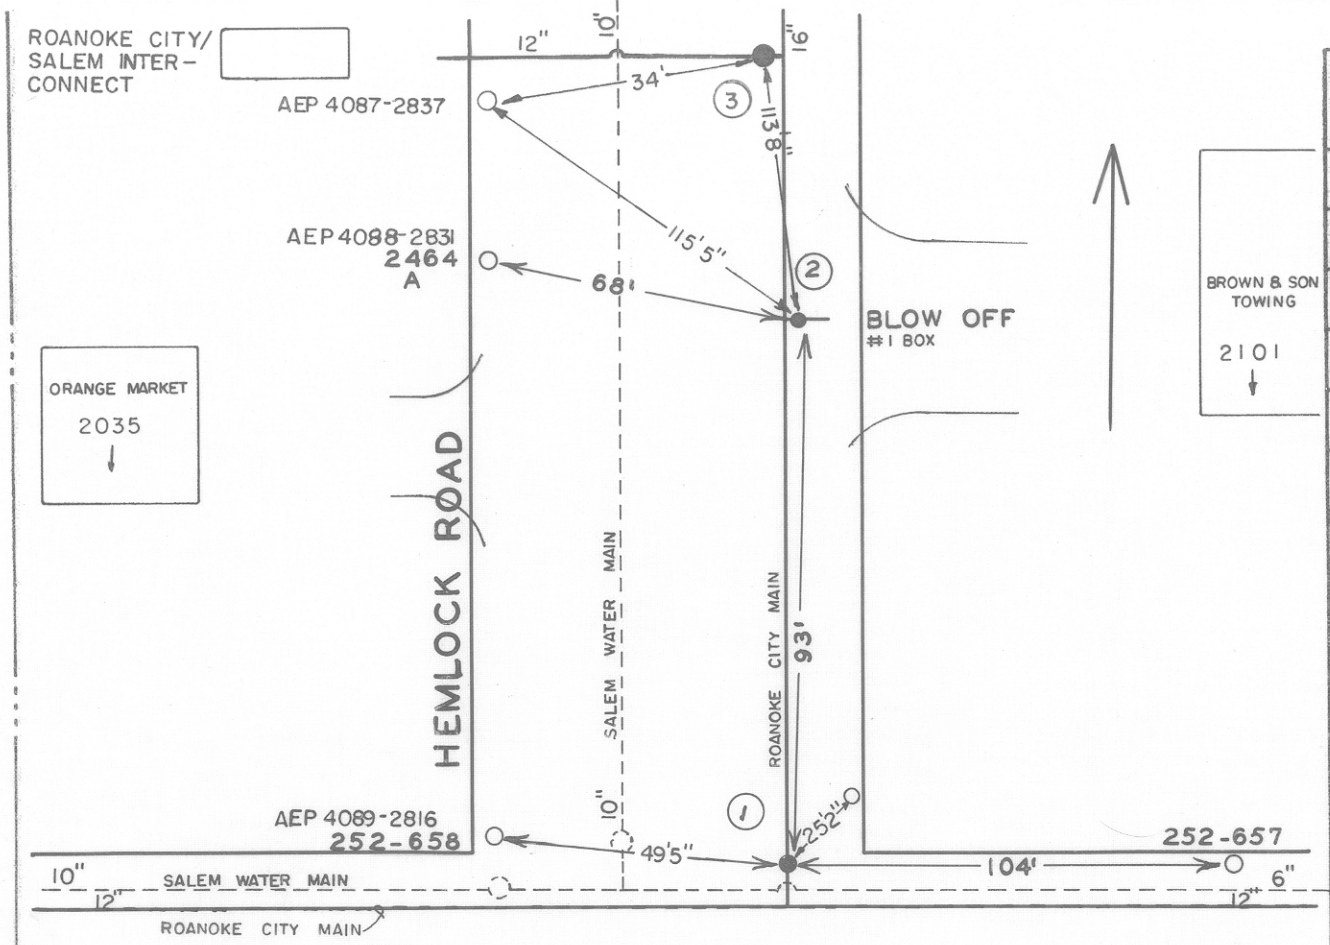

DATE	NO.	SIZE	MAKE	OPEN	TURNS
6-63	1	12"	DARLING	R	38
6-63	2	6"	DARLING	R	20
1987	3	12"			
	1	2'S	N.P.L.		

SHENANDOAH AVENUE (NAMED ROANOKE BLVD IN SALEM)

VA HOSPITAL

NOTE- VALVE BOXES ARE CLOW ADJUSTABLE TYPE ① + ②

10/98 NP

CITY OF ROANOKE – WATER DEPT.

VALVE DIAGRAM

HEMLOCK ROAD &

SHENANDOAH AVENUE N.W.

(ROANOKE BLVD. IN SALEM)

SEC. MAP 40, S224,225 SALEM

DATE PAGE NO.