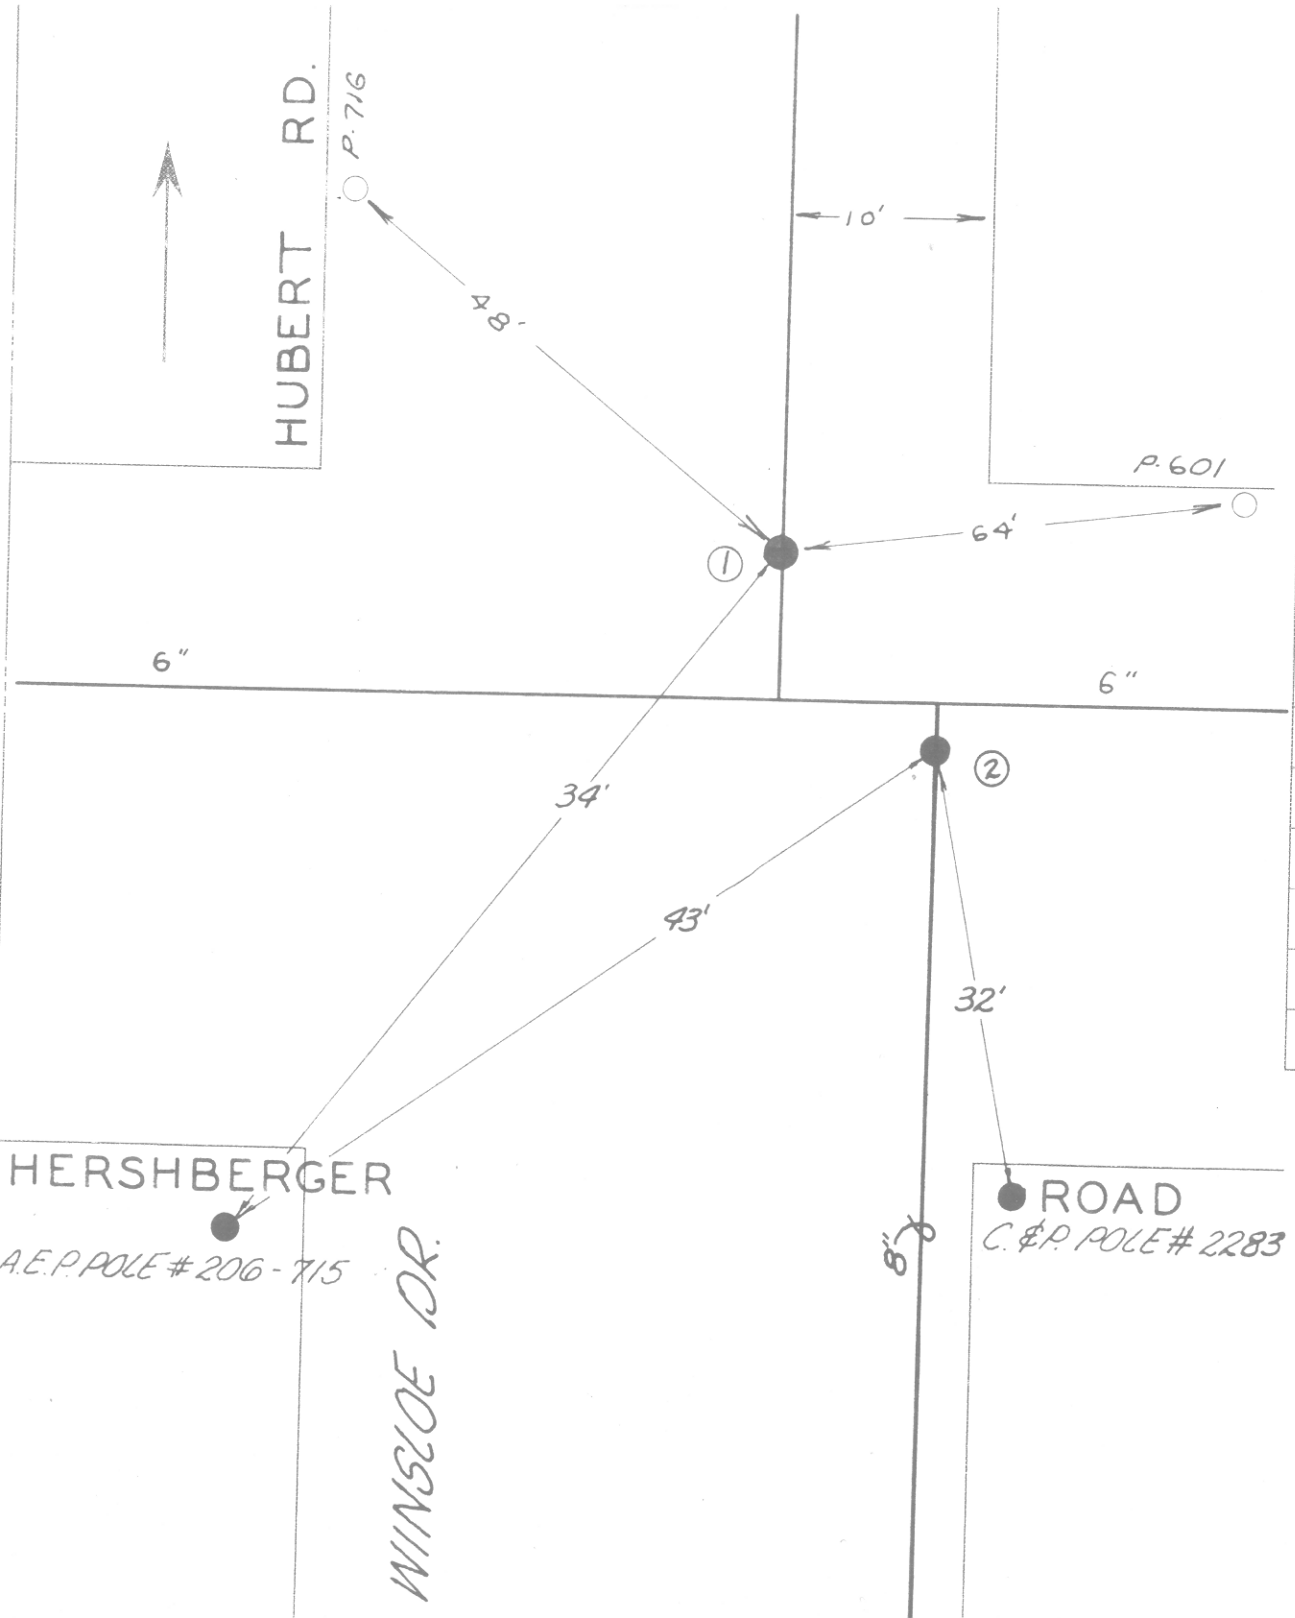

DATE	NO.	SIZE	MAKE	OPEN	TURNS
	1	6"			
7-75	2	6"	MUELLER	R	21
	1	8" S	NPL		

CITY OF ROANOKE — WATER DEP'T

VALVE DIAGRAM

HERSHBERGER RD. &

HUBERT RD. N. W.

SEC. MAP 220

DATE PAGE NO.