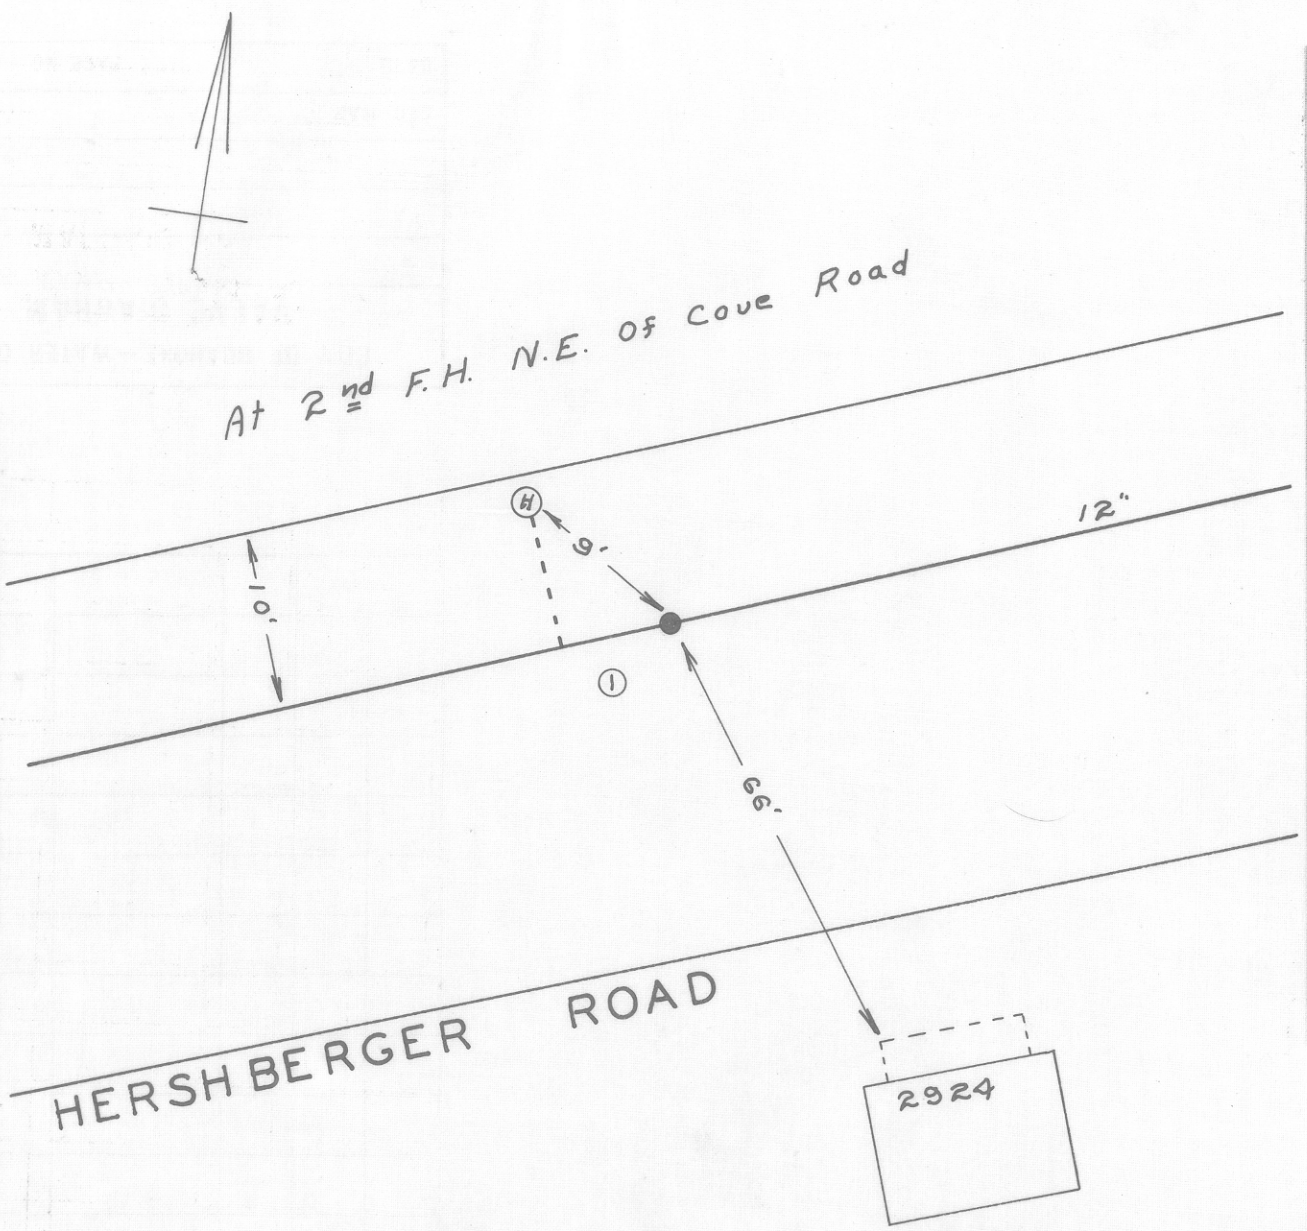

DATE	NO.	SIZE	MAKE	OPEN	TURNS
	1	12"	MUELLER	R	38
	1	1400'-	E EPL	COVE	RD.

CITY OF ROANOKE — WATER DEPT.

VALVE DIAGRAM

HERSHBERGER RD. 1400'

E. OF COVE RD. N.W.

SEC. MAP 248

DATE PAGE NO.

"IMPERIAL" TRACING CLOTH. K & E CO., N. Y.