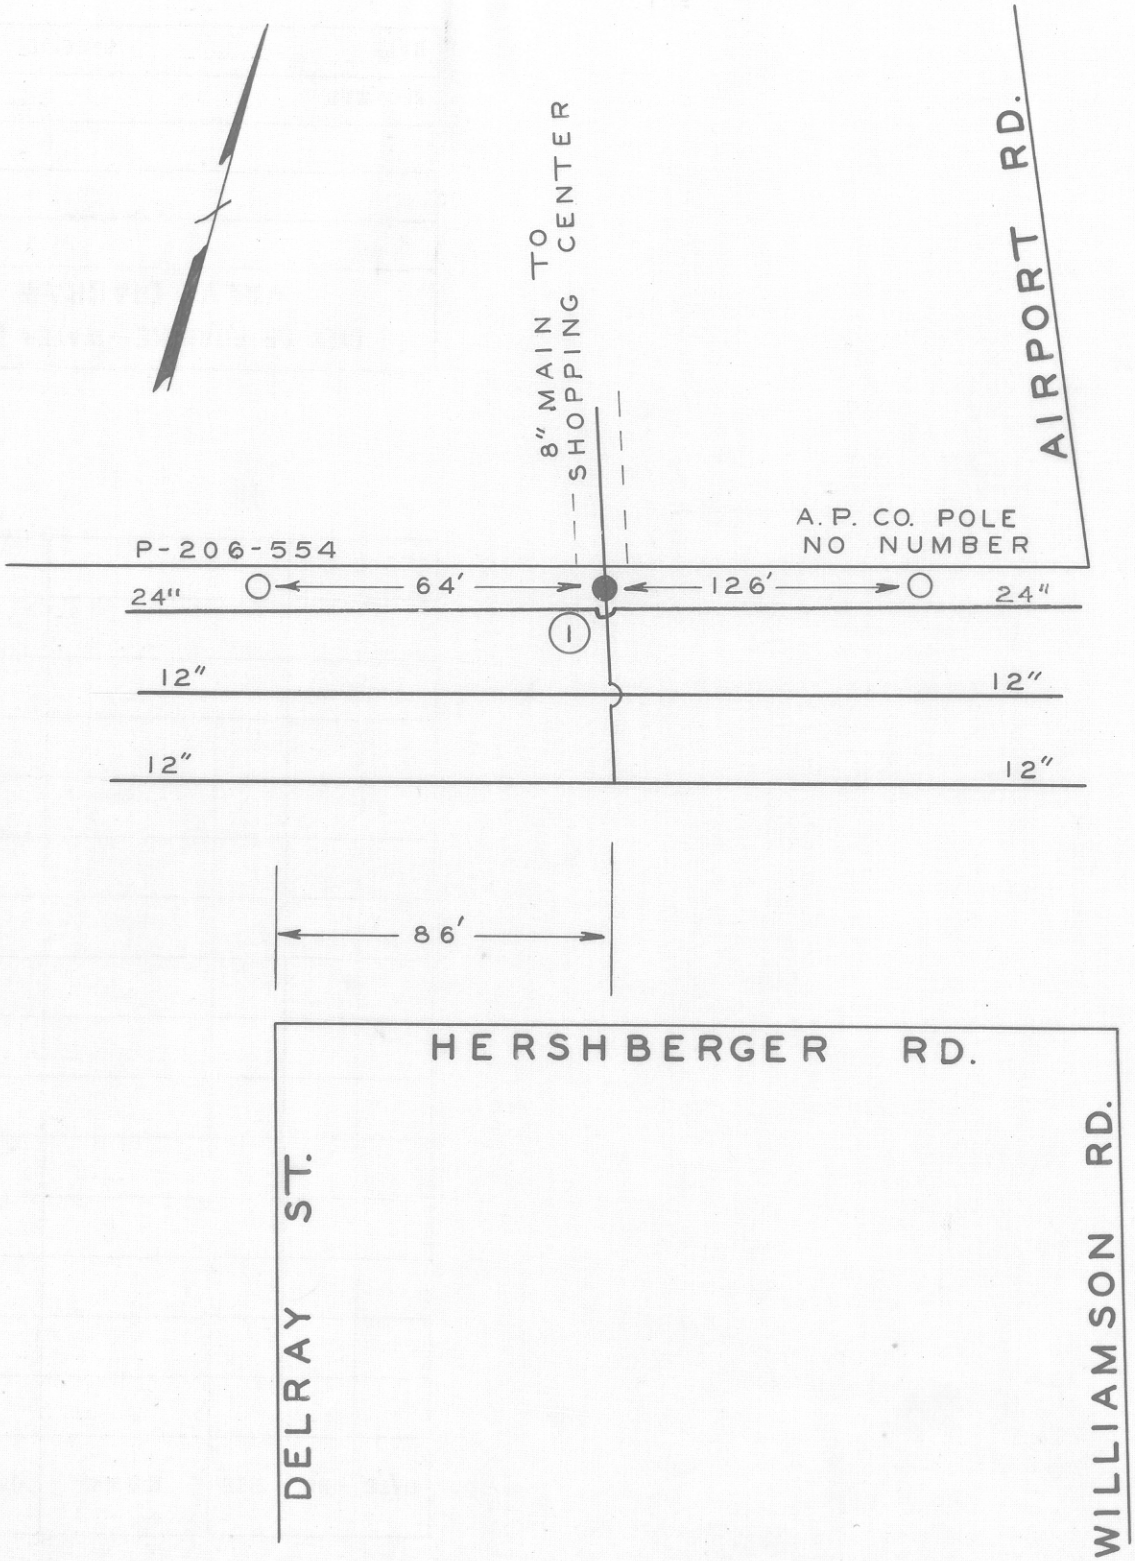

DATE	NO.	SIZE	MAKE	OPEN	TURNS
'61	1	8"	DAR.	R	26½

CITY OF ROANOKE — WATER DEPT.

VALVE DIAGRAM

HERSHBERGER RD. N.W.

BET. DELRAY ST. &

WILLIAMSON RD.

SEC. MAP 228

DATE PAGE NO.

"IMPERIAL" TRACING CLOTH
K & E CO., N. Y.