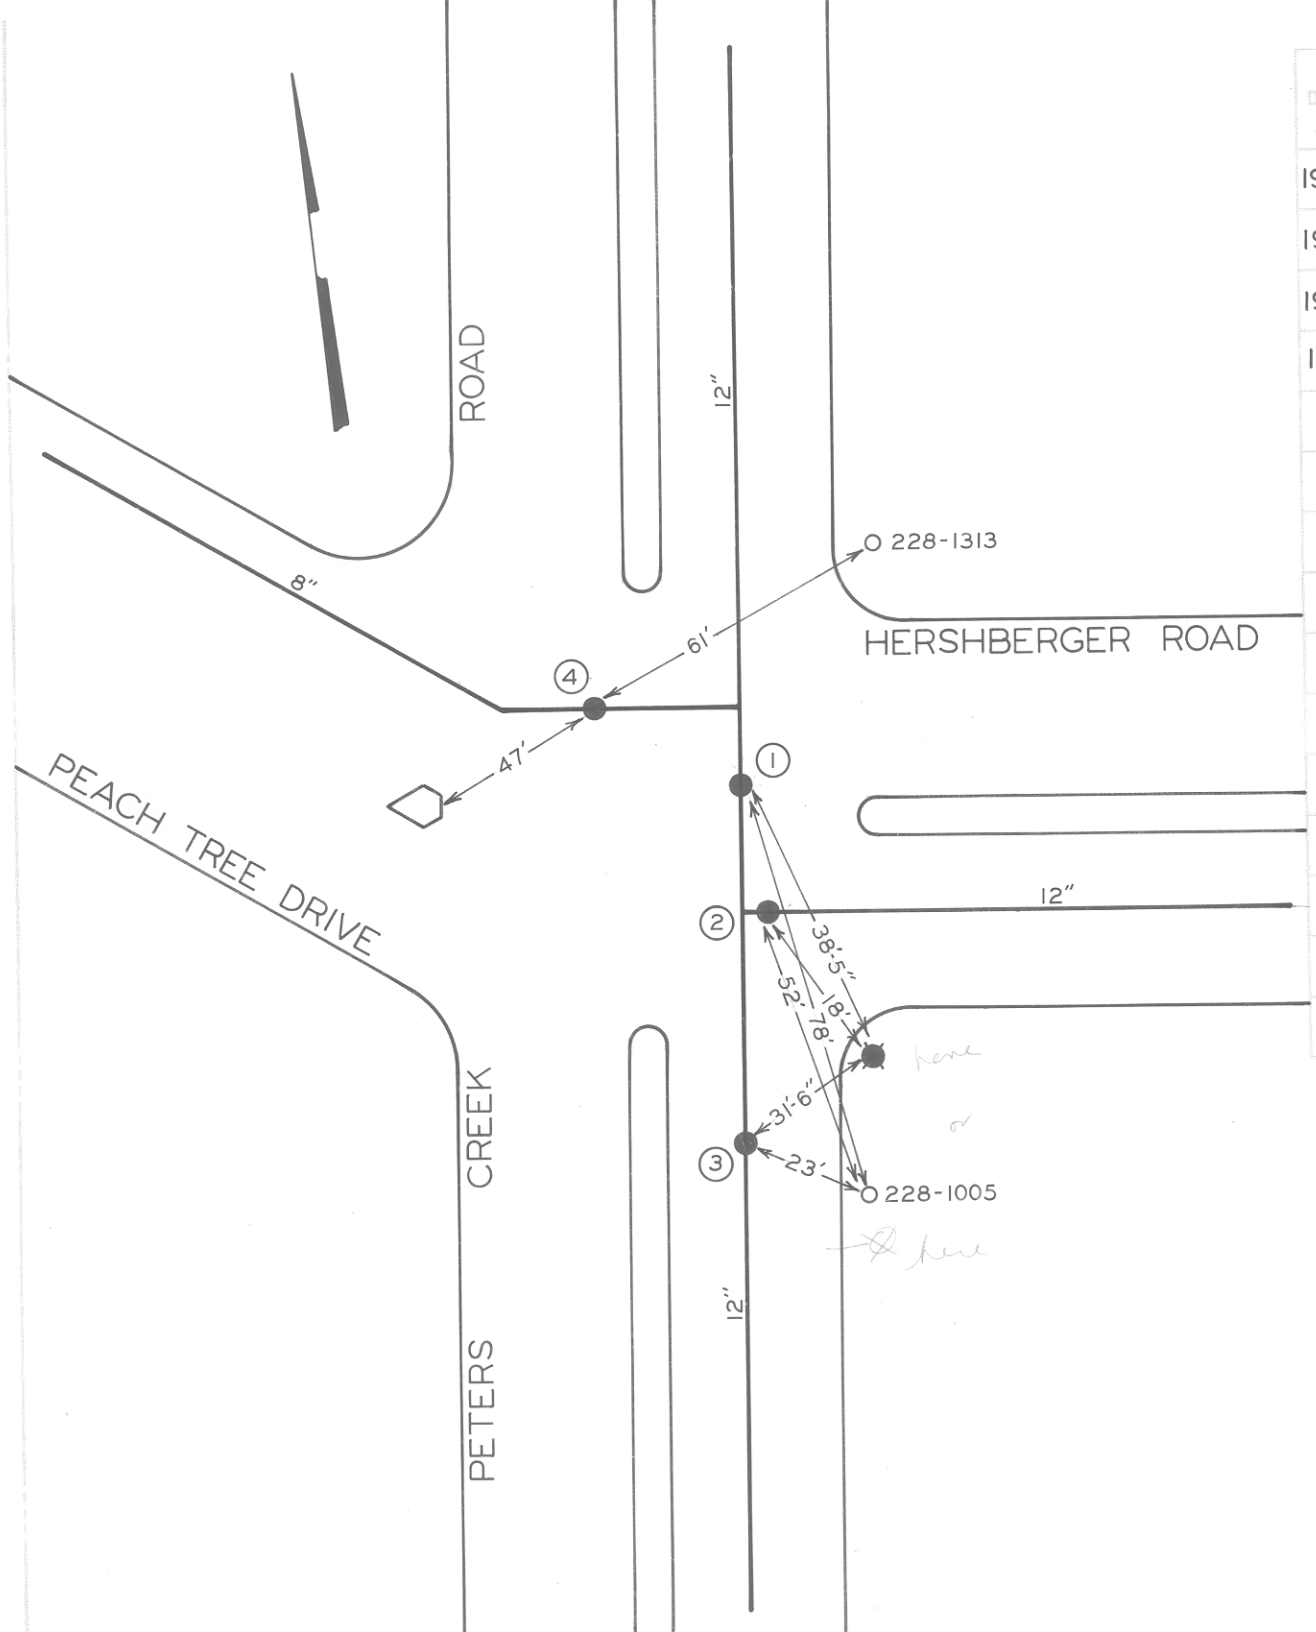

DATE	NO.	SIZE	MAKE	OPEN	TURNS
1975	1	12"	MUELLER	R	38
1953	2	12"	MUELLER	R	38
1953	3	12"	MUELLER	R	38
1954	4	8"	MUELLER	R	27

CITY OF ROANOKE—WATER DEP'T

VALVE DIAGRAM

HERSHBERGER ROAD, PEACH TREE DRIVE PETERS CREEK ROAD

SEC. MAP 612 N.W.

DATE PAGE NO.