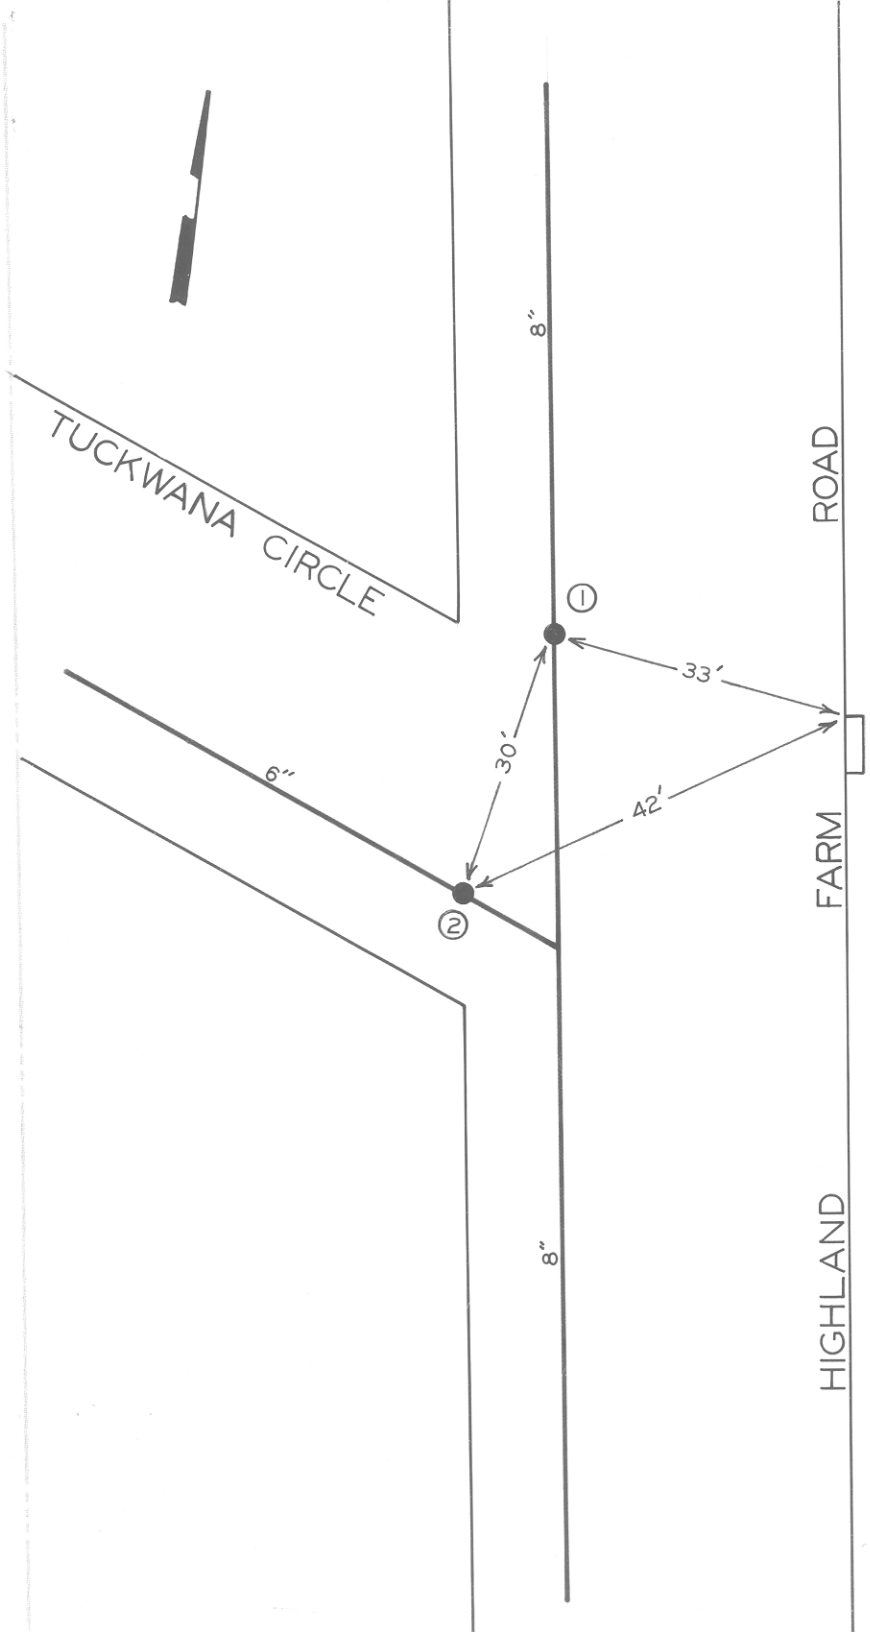

DATE	NO.	SIZE	MAKE	OPEN	TURNS
69	1	8"	MUELLER	R	27
69	2	6"	MUELLER	R	21

CITY OF ROANOKE—WATER DEP'T

VALVE DIAGRAM

HIGHLAND FARM ROAD &
TUCKWANA CIRCLE N.W.

SEC. MAP

DATE PAGE NO.