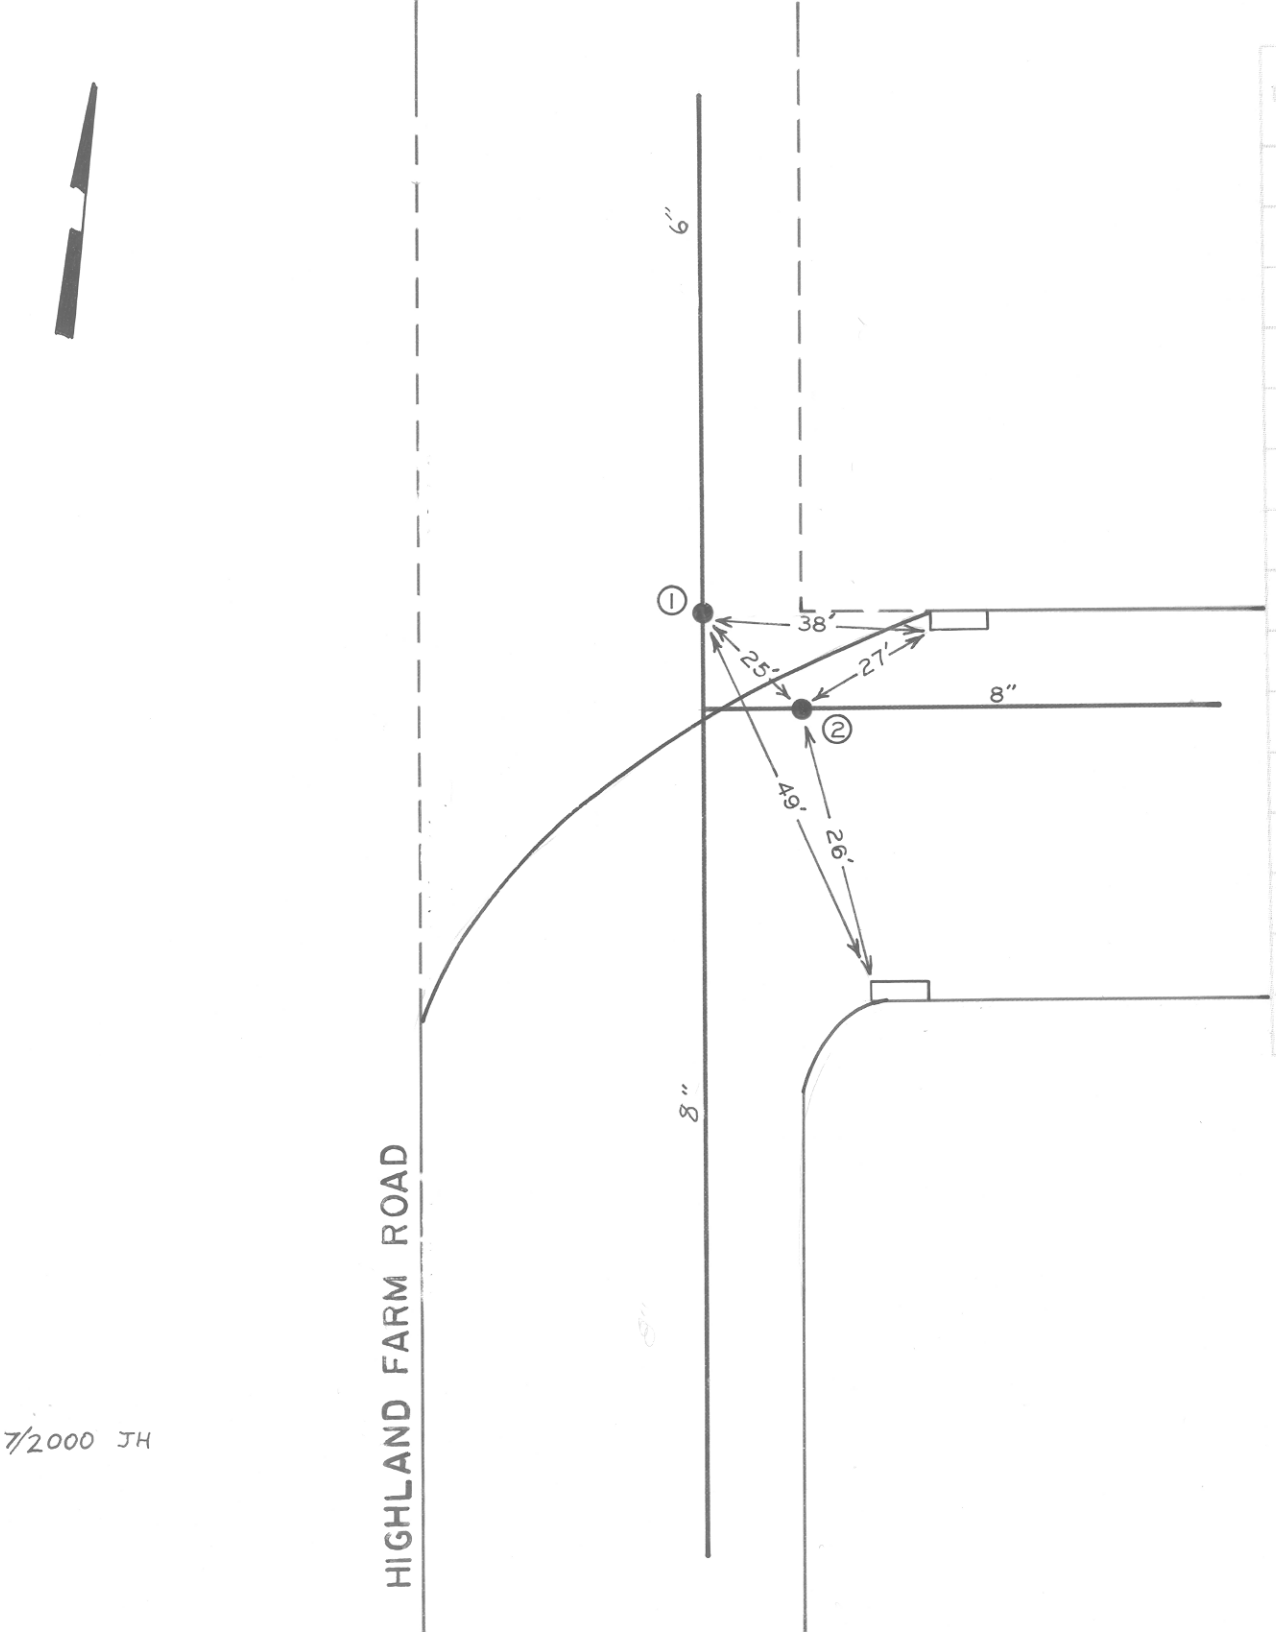

DATE	NO.	SIZE	MAKE	OPEN	TURNS
69	1	6"	MUELLER	R	21
69	2	8"	MUELLER	R	27

7/2000 JH

CITY OF ROANOKE — WATER DEP'T

VALVE DIAGRAM

HIGHLAND FARM ROAD N.W.

2100 BLOCK

SEC. MAP 647

DATE PAGE NO.